


T.35S.R.33E.W.M.

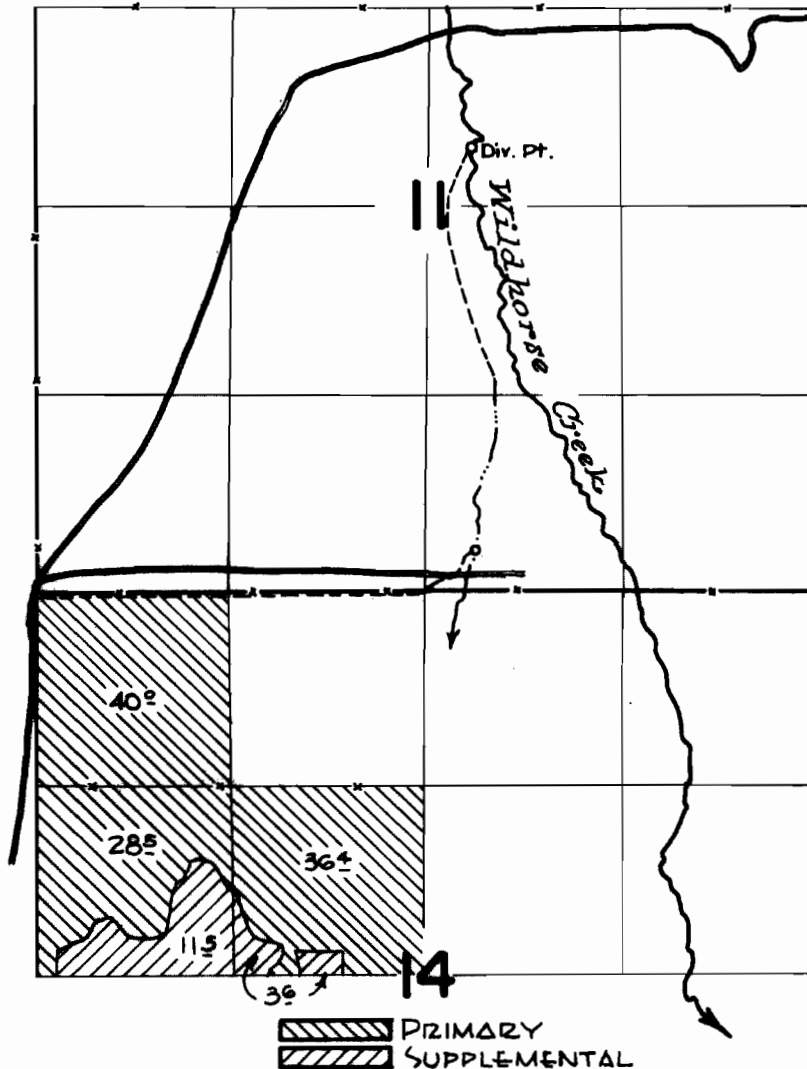

FINAL PROOF SURVEY
UNDER

Application No. 25974. Permit No. 23220.
IN NAME OF

JOHN HENRY PENLAND

Surveyed Aug. 24 1963, by C. R. BAKER.