


T.35S.R.33E.W.M.

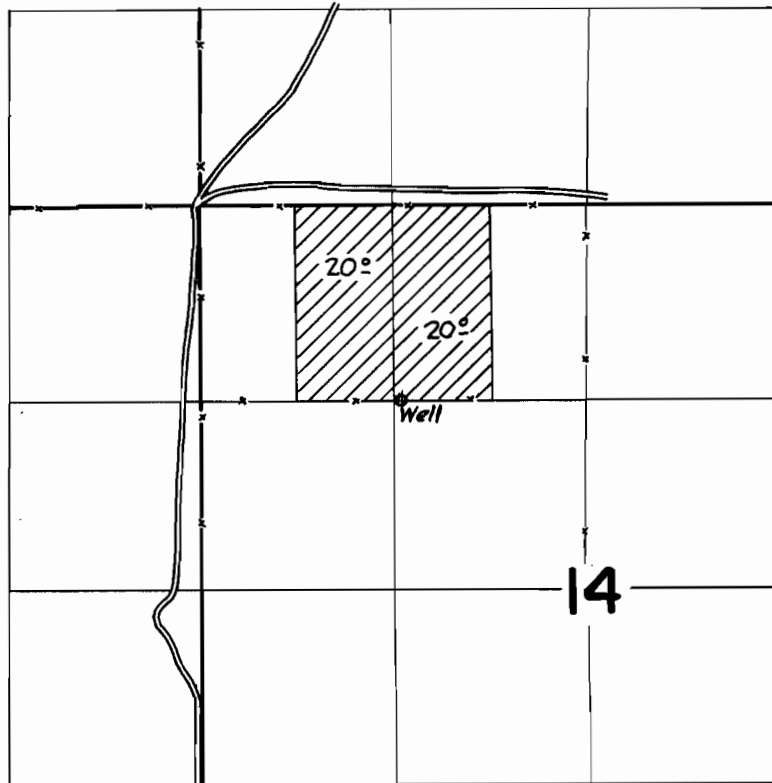

FINAL PROOF SURVEY
UNDER

Application No. U-423. Permit No. U-672.
IN NAME OF

JOHN HENRY PENLAND

Surveyed Aug. 24 1963, by C. R. BAKER