


T.36S.R.1W.W.M.

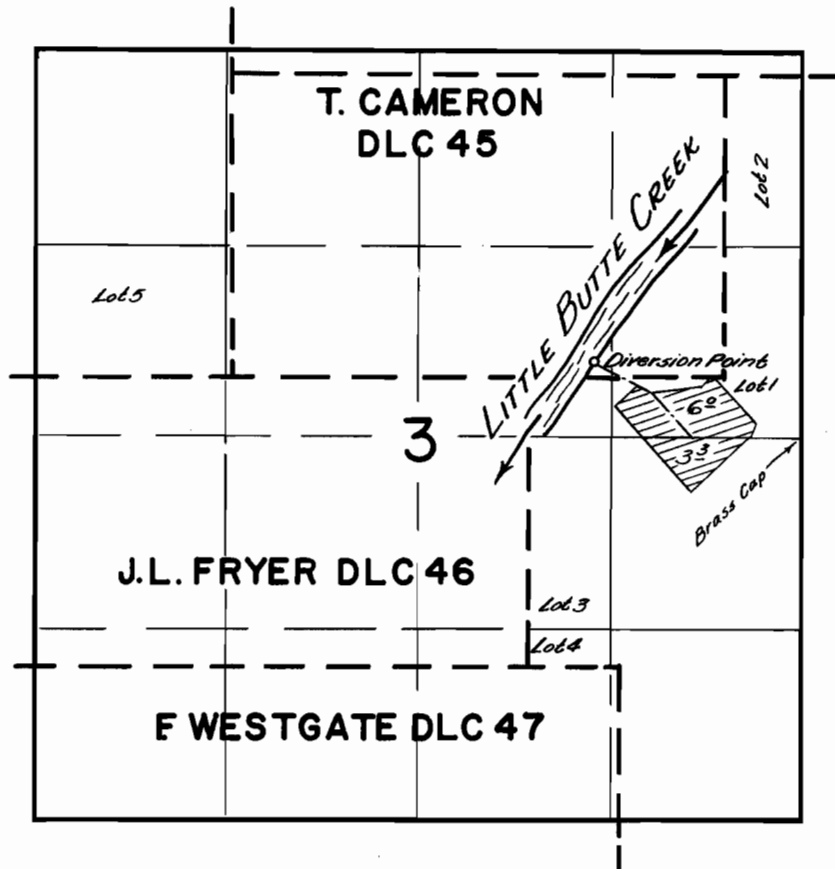

FINAL PROOF SURVEY
UNDER

Application No. 31852 Permit No. 25112
IN NAME OF

Eagle Point School Dist 9

Surveyed June 13 1963, by C. Baker