


T.38S.R.4W.W.M.

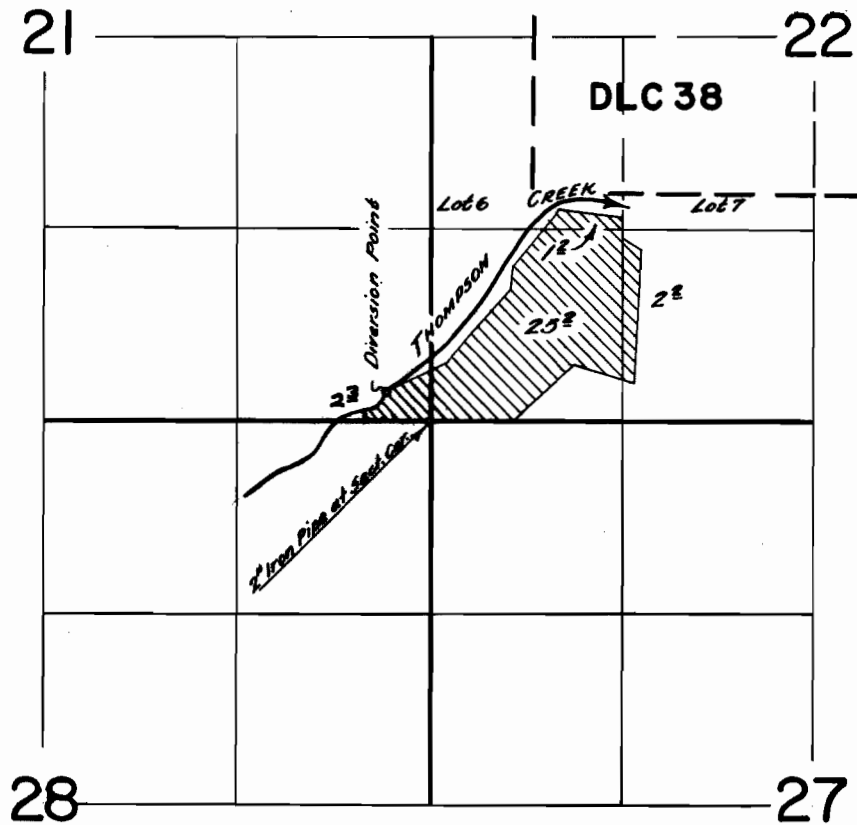

**FINAL PROOF SURVEY**  
UNDER

Application No. 32111... Permit No. 25336...  
IN NAME OF

.....**Marvin R. Anderson**.....

Surveyed July 17, 1963, by G. Baker.....