


T. 35 S. R. 4 W. W.M.

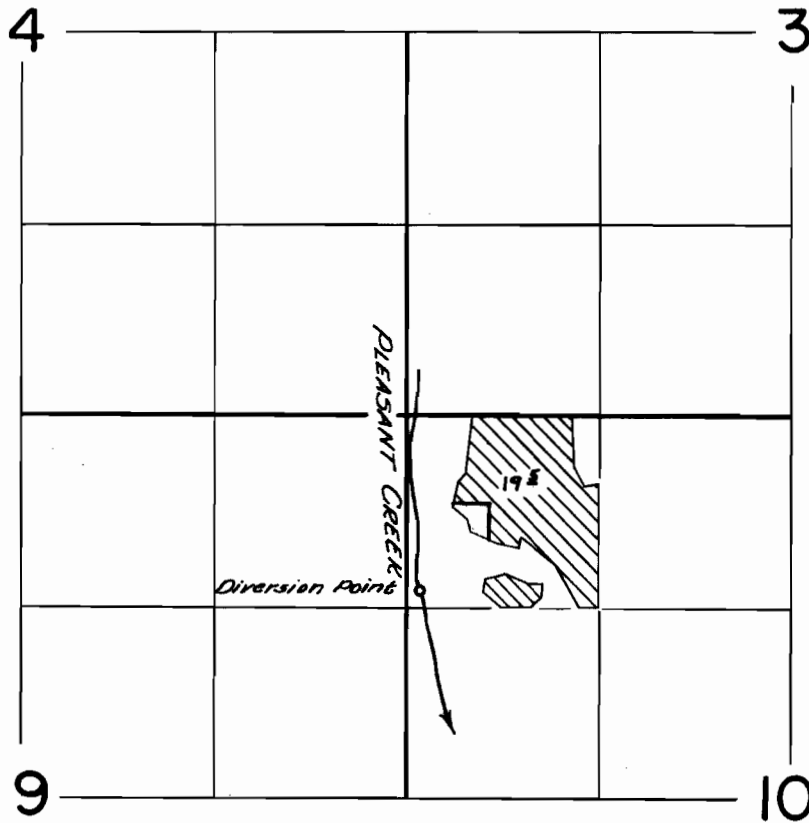

FINAL PROOF SURVEY
UNDER

Application No. 3.2.2.41. Permit No. 25435...
IN NAME OF

WM. H. & BONNIE M. SIMMONS

Surveyed July 10, 1963, by C. Baker.....