


T. 32 S. R. 1 E. W. M.

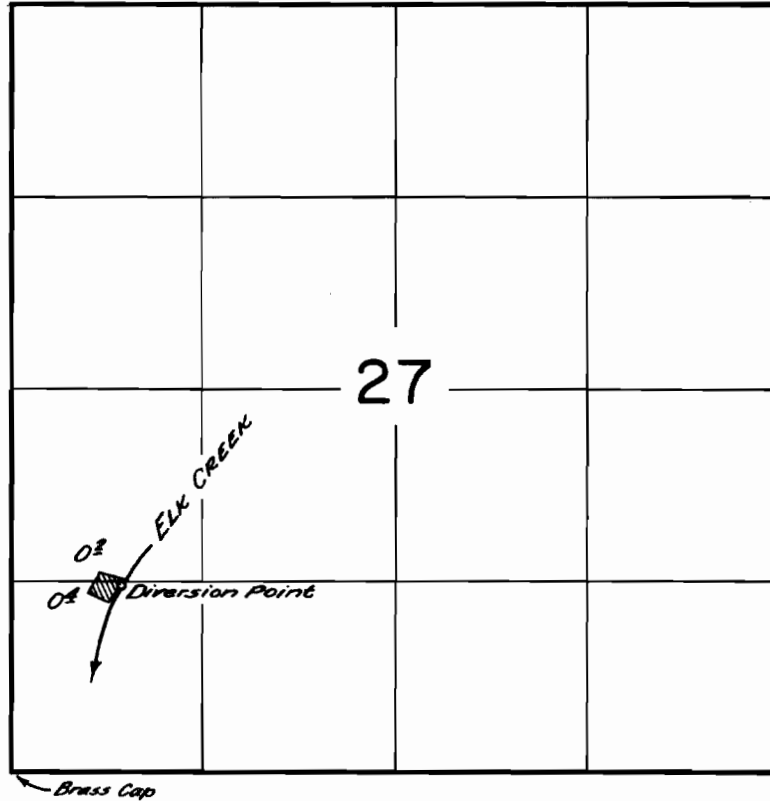

**FINAL PROOF SURVEY**  
UNDER

Application No. 33168... Permit No. 26334...  
IN NAME OF

.....**Manly F. and Hyacinth A. Bryant**.....

Surveyed July 16... 1963, by **G. Baker**.....