


T. 38 S. R. 4 E. W. M.

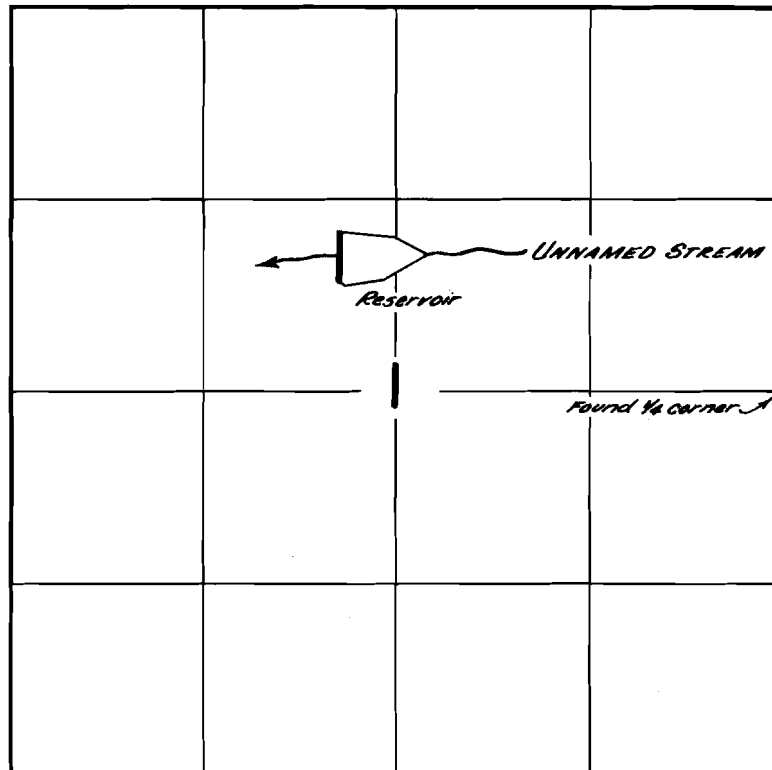

FINAL PROOF SURVEY
UNDER

Application No. R-33411 33410 Permit No. R-2297 26449
IN NAME OF

Earl M. Manley

Surveyed May 14 1963, by C. Baker