


T.34S.R.IW.W.M.

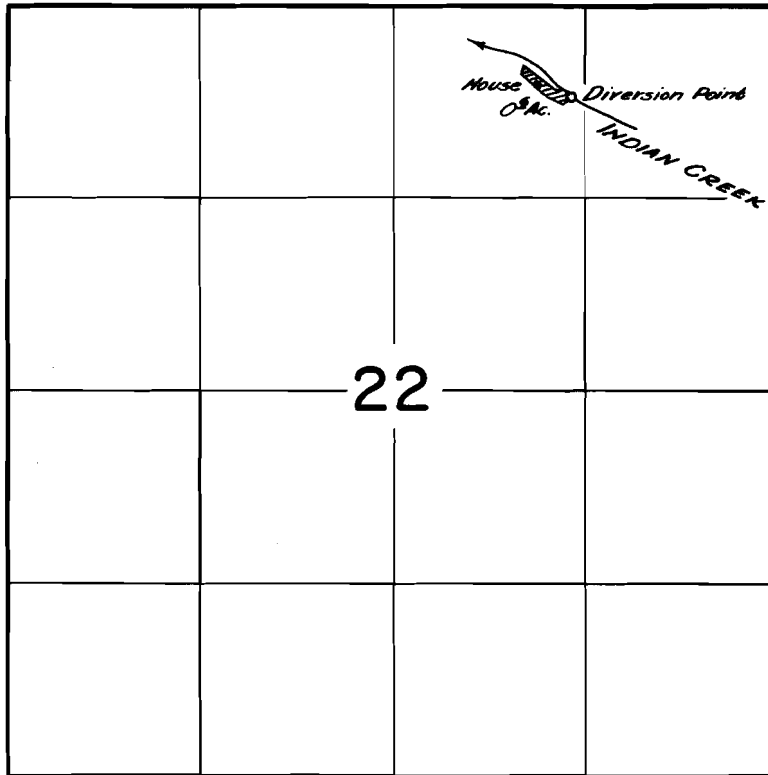

FINAL PROOF SURVEY
UNDER

Application No. 33490.. Permit No. 26497..
IN NAME OF

...**Alfred N. and Malinda J. Johnson**.....

Surveyed July...9... 1963, by ...C.Baker.....