


T.36S.R.4 W.W.M.

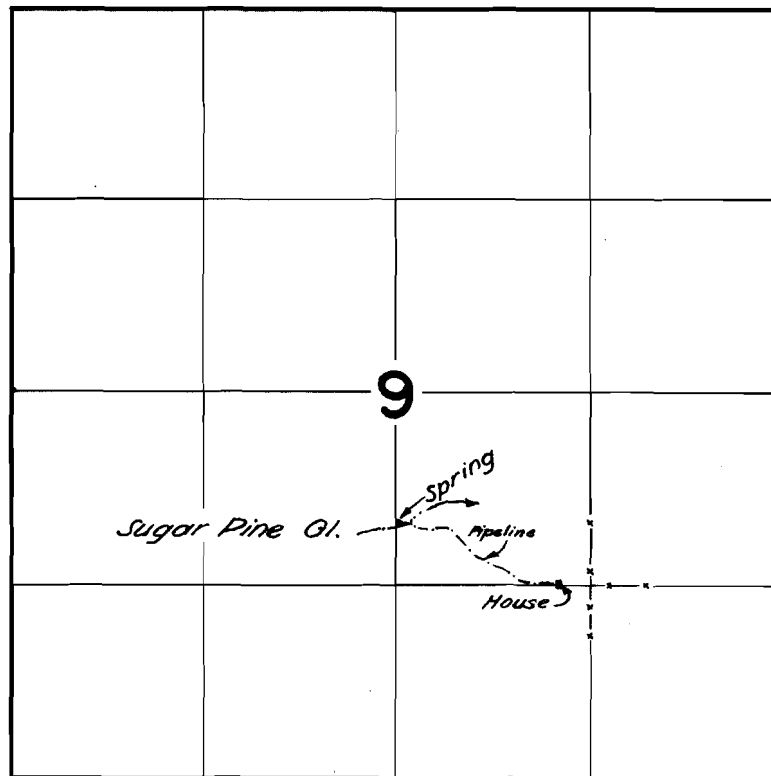

FINAL PROOF SURVEY
UNDER

Application No. 33506... Permit No. 26503...
IN NAME OF

.....
EARL C. SIMONSEN
.....

Surveyed *May 20 1963*, by *[Signature]*