


T. 38 & 39 S. R. 1 E. W. W.

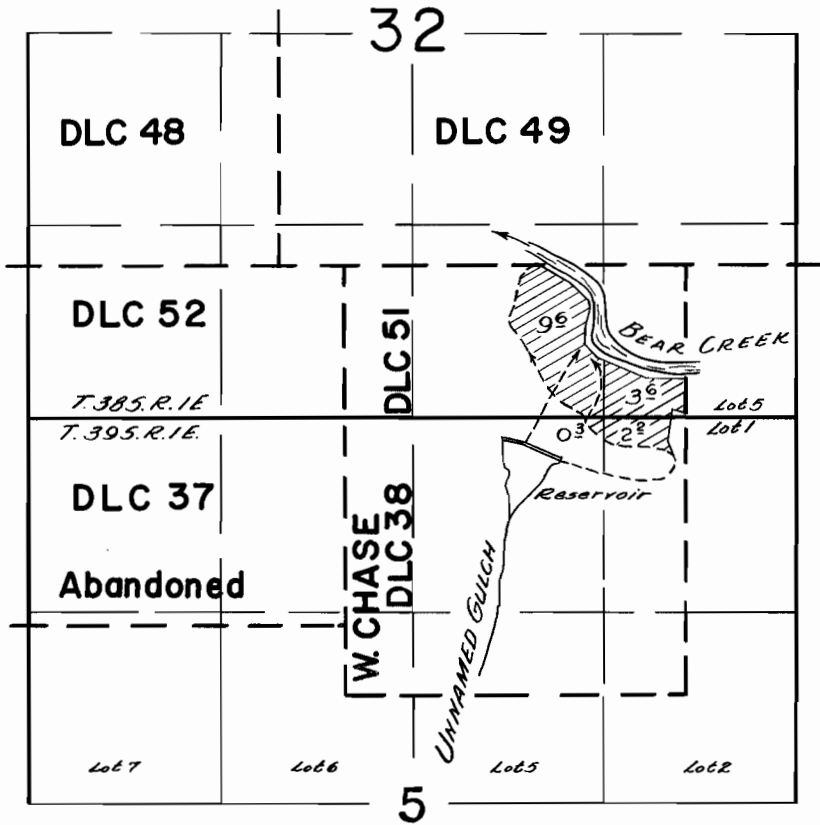

FINAL PROOF SURVEY
UNDER

Application No. R-33601 33602 Permit No. R-2326 26570
IN NAME OF

John S. Billings

Surveyed May 14 1963, by C. Baker