


T.40S.R.3W.W.M.

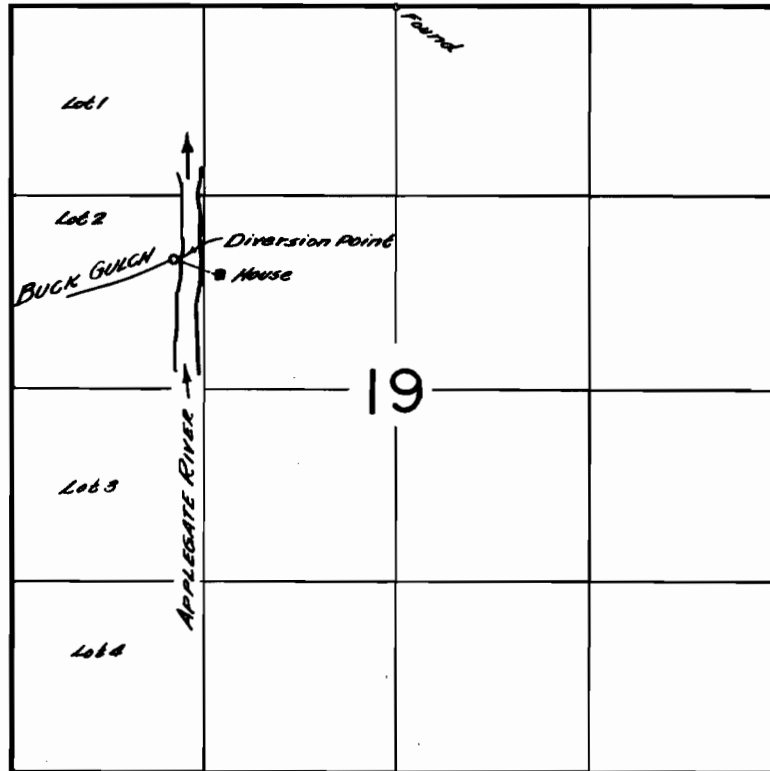

**FINAL PROOF SURVEY**  
UNDER

Application No. 33908 Permit No. 26714  
IN NAME OF

Gertrude Heitkamp

Surveyed May 16 1963, by C. Baker