


T. 38S. R. 3W. W.M.

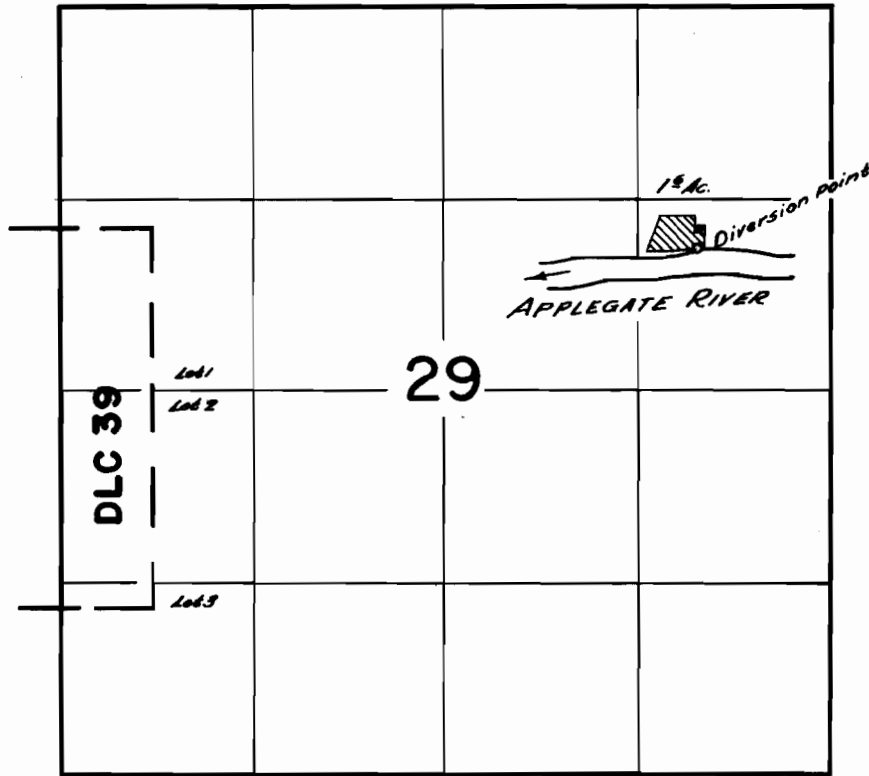

FINAL PROOF SURVEY
UNDER

Application No. 33773 Permit No. 26739...
IN NAME OF

.....**Bruce J. Manley**.....

Surveyed May 20 1963, by G. Baker.....