


T.35 S. R.2 W.W.M.

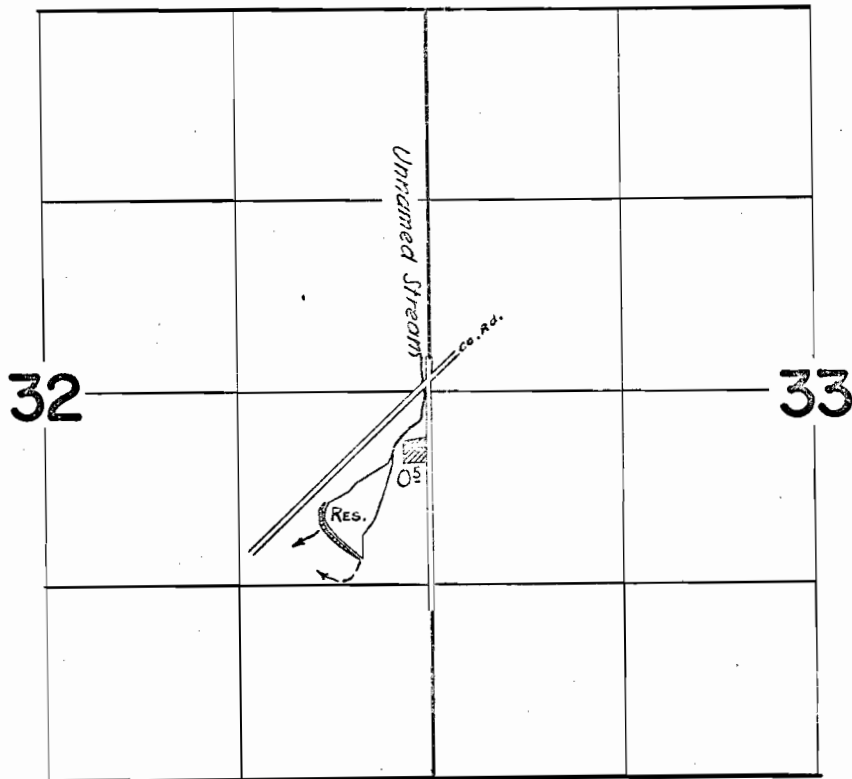

FINAL PROOF SURVEY
UNDER

R-34318 R-2471
Application No. 34319 Permit No. 26983
IN NAME OF

JAMES D. STRAUS

Surveyed May 15, 1963, by

R. Jackson