


T. 34S. R. 1W. W.M.

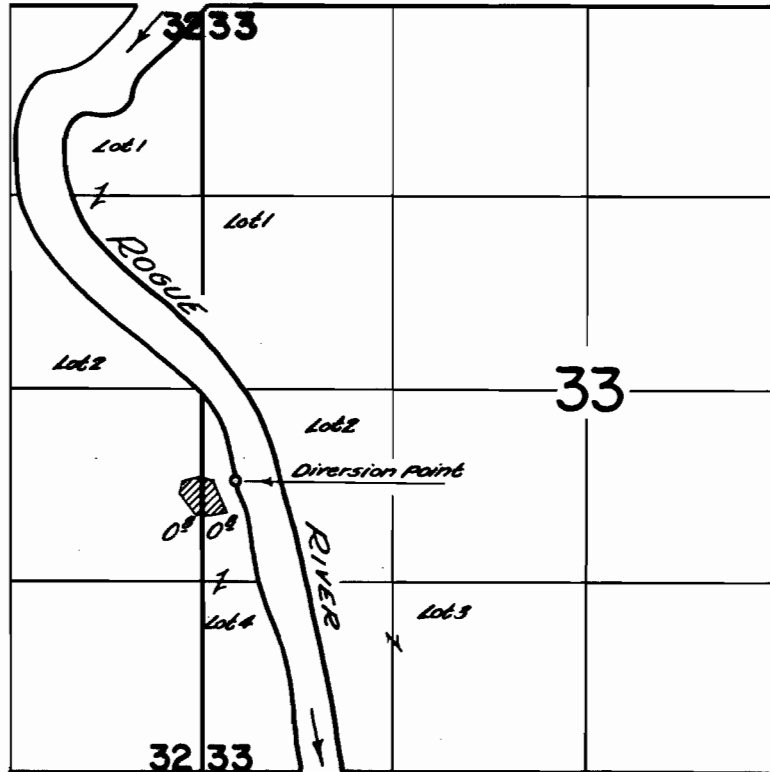

FINAL PROOF SURVEY
UNDER

Application No. 34557. Permit No. 27141.....
IN NAME OF

.....**Horace L. & Miriam R. Failing**.....

Surveyed July 9, 1963, by C. Baker.....