


T.36S.R.3W.W.M.

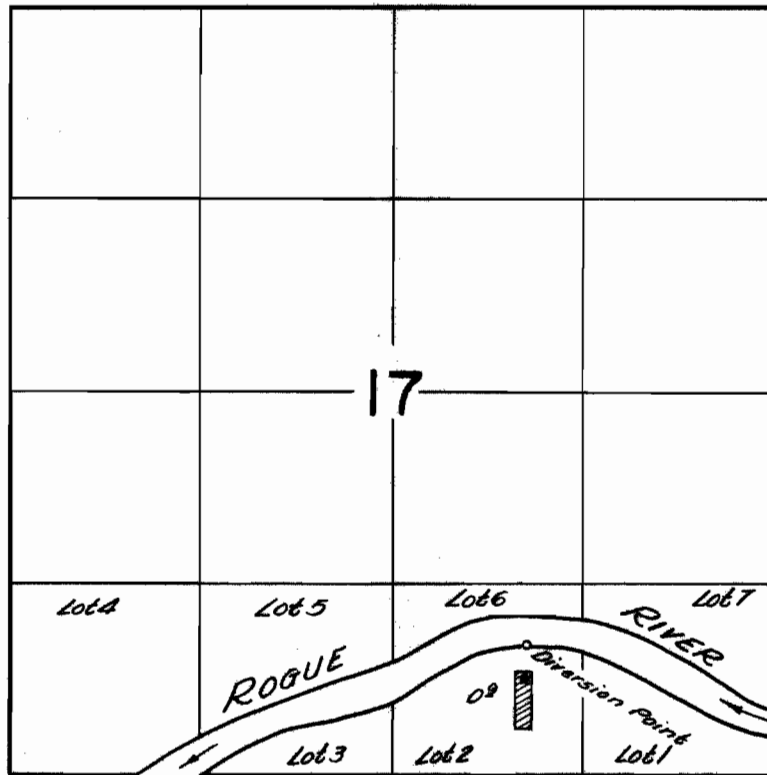

**FINAL PROOF SURVEY**  
UNDER

Application No. 35096 Permit No. 27458

IN NAME OF

**FREDRICK T. & MARILYN J. ZAUSKEY**

Surveyed July 13 1963, by C. Baker