


T. 36S.R. 4W.W.M.

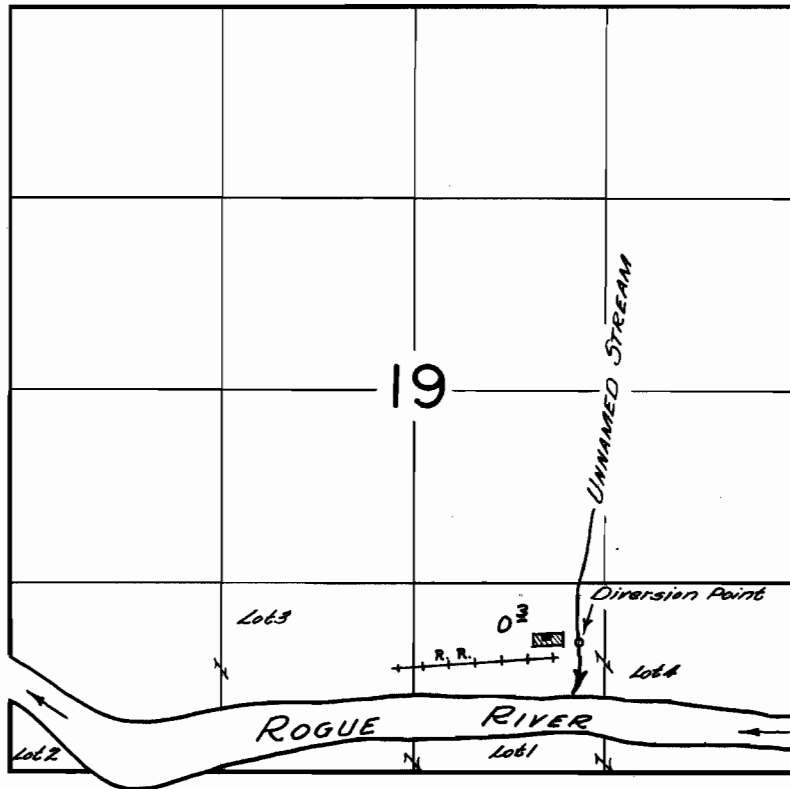

**FINAL PROOF SURVEY**  
UNDER

Application No. 37187... Permit No. 27716...  
IN NAME OF

.....William Tait.....

Surveyed July 13... 1963., by C. Baker.....