


T. 34S. R. 2W. W.M.

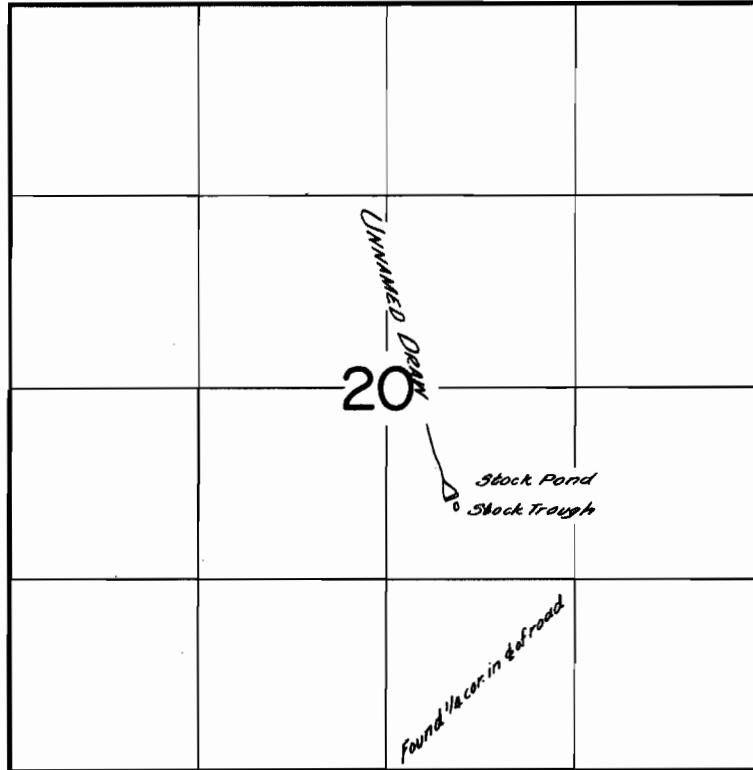

FINAL PROOF SURVEY
UNDER

Application No. R-37233 37234 Permit No. R-2707 27749
IN NAME OF

Venson A. Hunt

Surveyed July 11 1963, by C. Baker