


T. 34S. R. 2W. W.M.

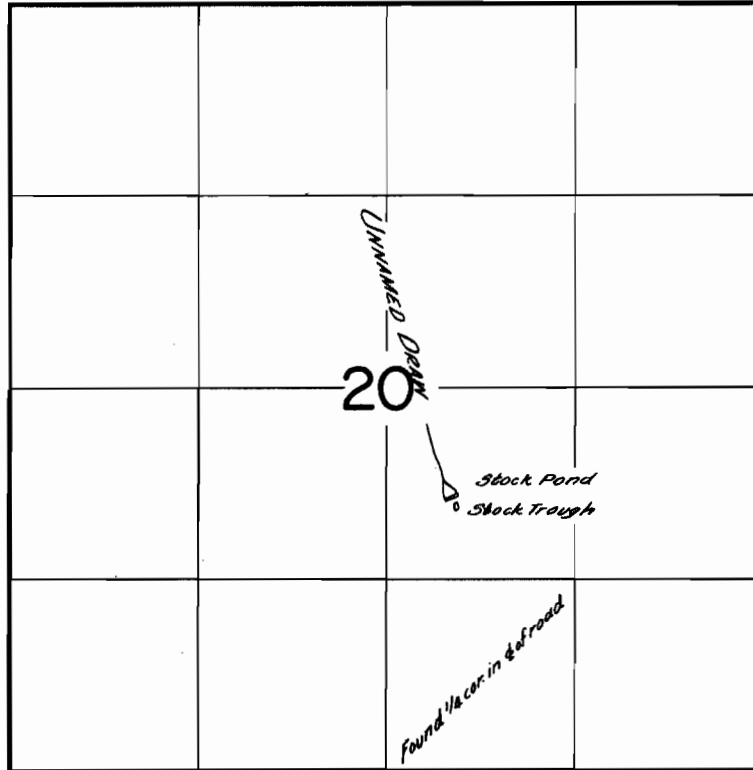

FINAL PROOF SURVEY
UNDER

Application No. R-37233 ~~37234~~ Permit No. R-2707 ~~27749~~
IN NAME OF

Venson A. Hunt

Surveyed July 11 1963, by C. Baker