


TWP. 36 S. R. 5 W. WM

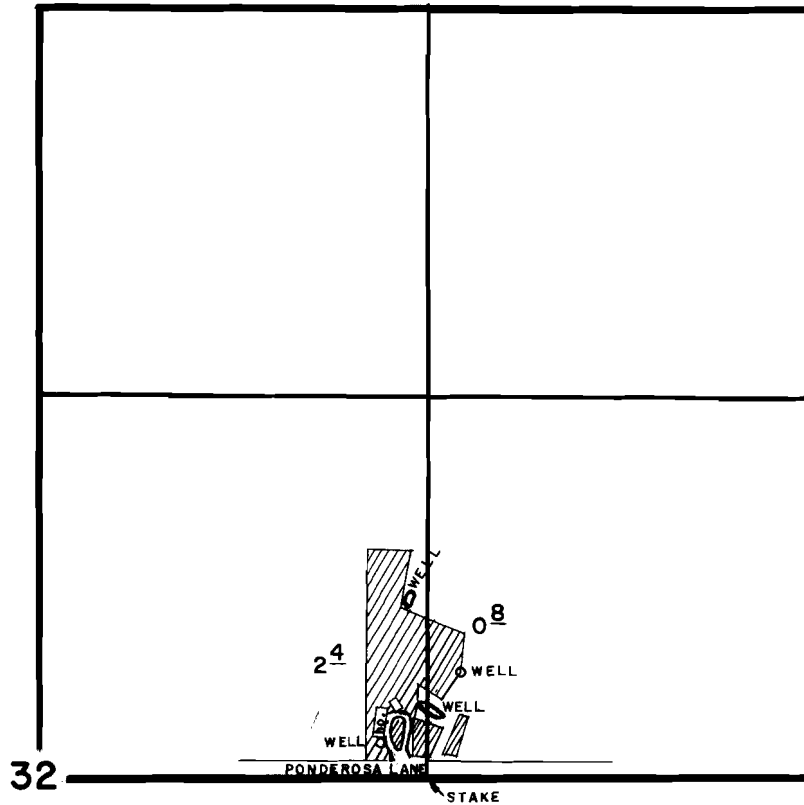

FINAL PROOF SURVEY

UNDER

SCALE: 8" = 1 MILE

Application No. G-1933 Permit No. G-1818
IN NAME OF

JOHN F. & PEGGY J. LUCKY

Surveyed AUG. 15 1963, by R. B. STEIMER