


T. 33 S. R. 6 W. W. M.

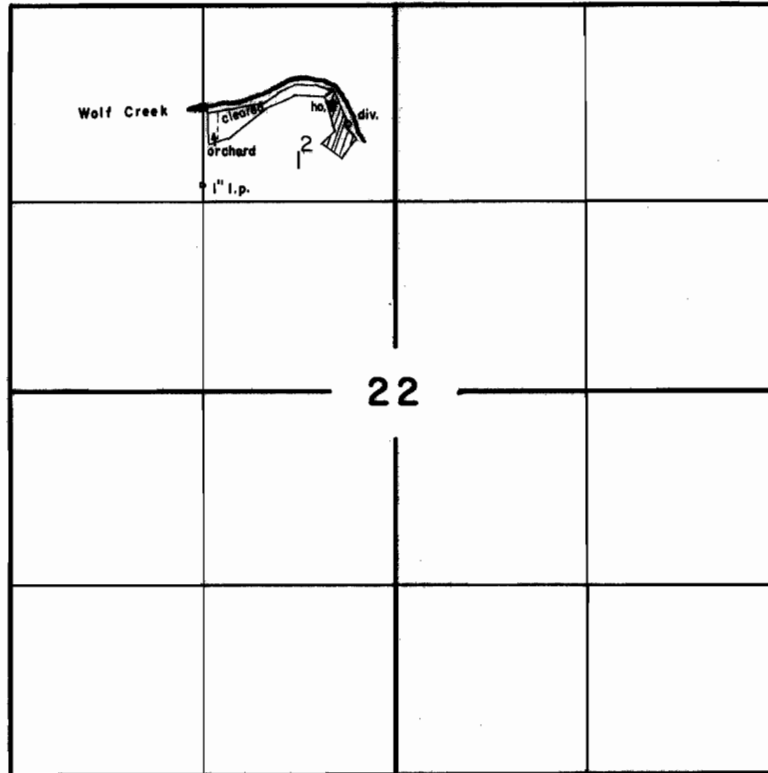

FINAL PROOF SURVEY
UNDER

Application No. 34157... Permit No. 26911.....
IN NAME OF

.....ALFRED K. HUGHES.....

Surveyed OCT. 20, 1964., by R.B. Steimer.....