


T.38S.R.5W.W.M.

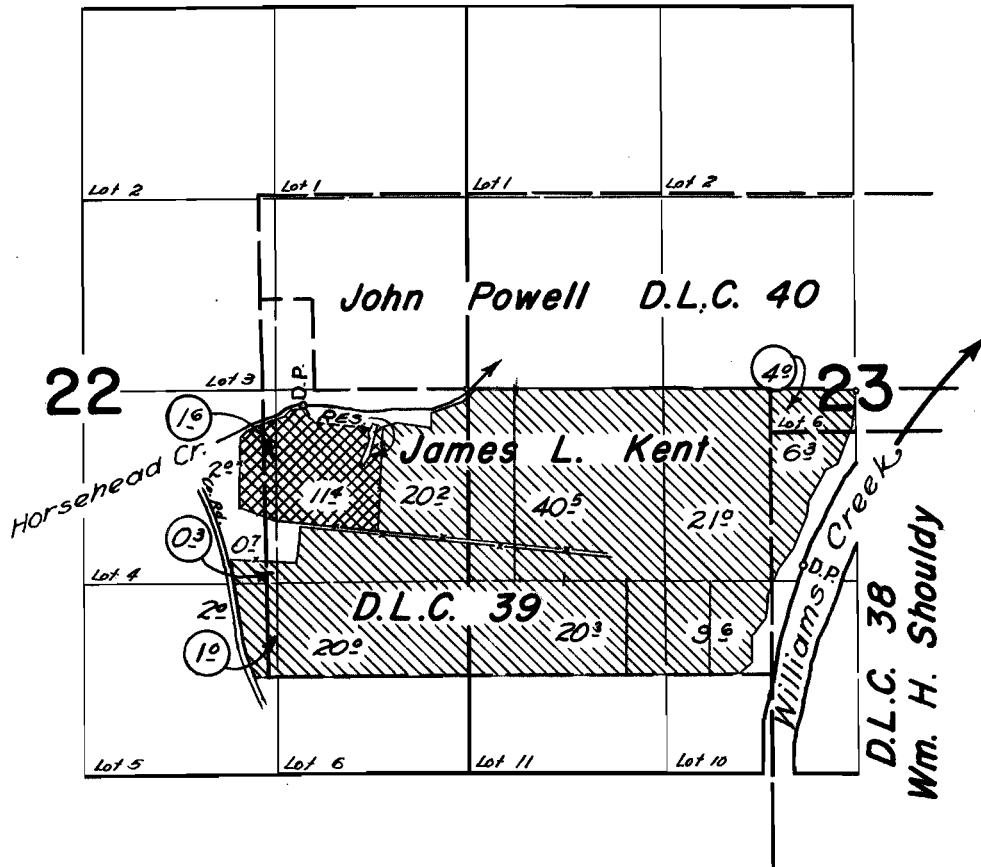

FINAL PROOF SURVEY
UNDER

Application No. 34475 Permit No. 27075
IN NAME OF

J. E. & DOROTHY FERRARE

Surveyed July 17, 1963, by [Signature]