


T 35 S R 7 W W M

1963  
JUL 26

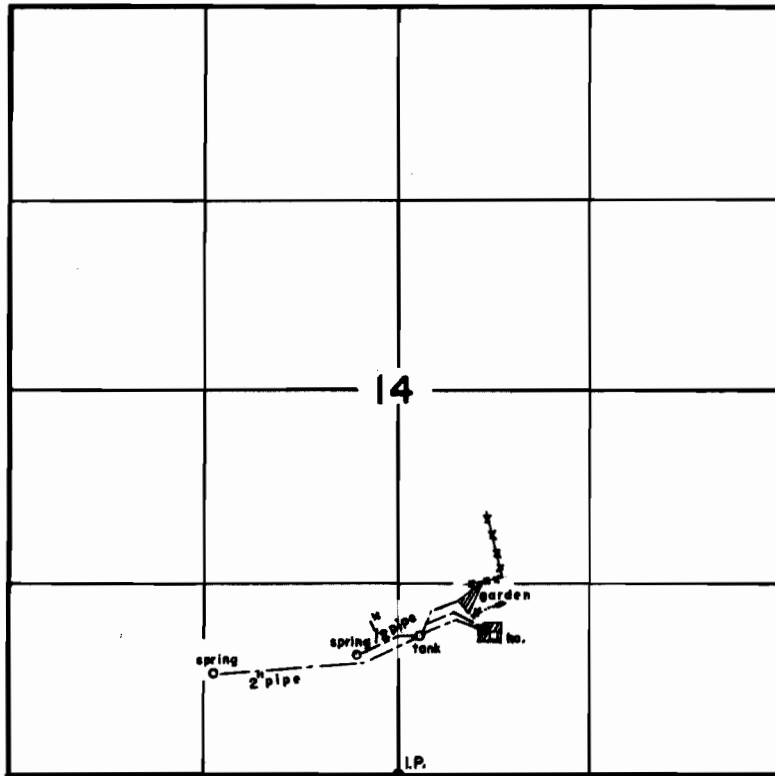

**FINAL PROOF SURVEY**  
UNDER

Application No. 34612..... Permit No. 27178...  
IN NAME OF

.....WILLIAM C. DEONIER.....

Surveyed JULY 26, 1963, by ...R.B. STEIMER