


T.35&36S.R.5W.W.M.

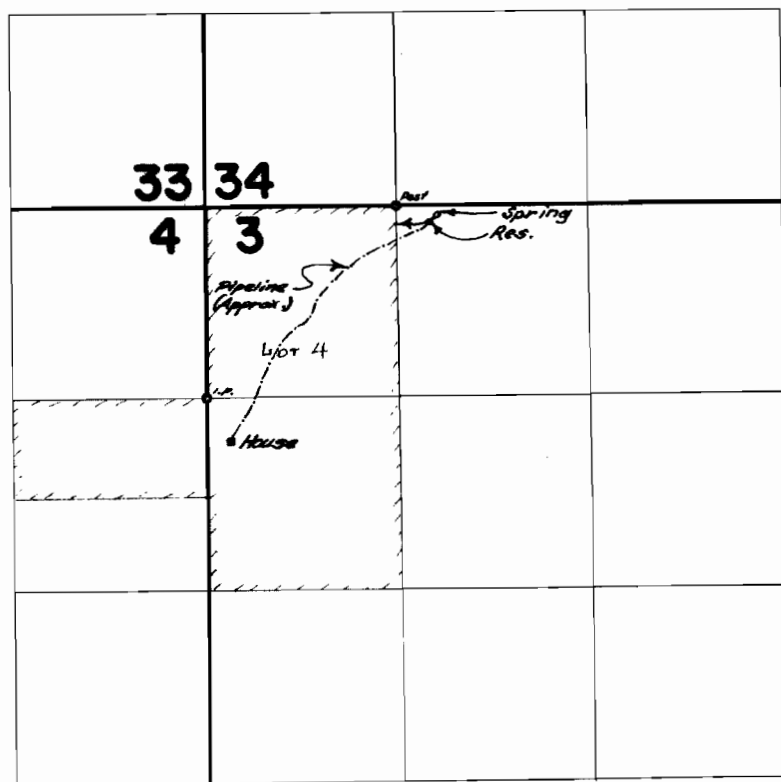

FINAL PROOF SURVEY
UNDER

Application No. 34781 Permit No. 27300
IN NAME OF

W. H. CULLUM

Surveyed June 6, 1963, by R. H. Jackson