


T. 35 S. R. 7 W.W.M.

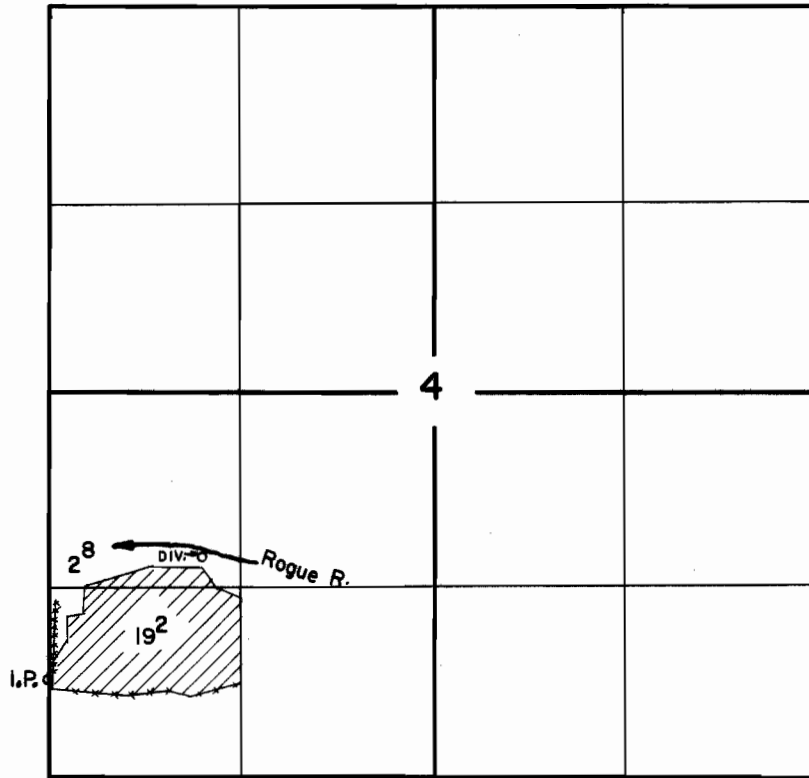

FINAL PROOF SURVEY
UNDER

Application No. 37750 Permit No. 28135
IN NAME OF

BD. CO. COM. JOSEPHINE CO.

Surveyed JUNE 16, 1964, by R. B. STEIMER