


T. 33 S. R. 6 W.W.M.

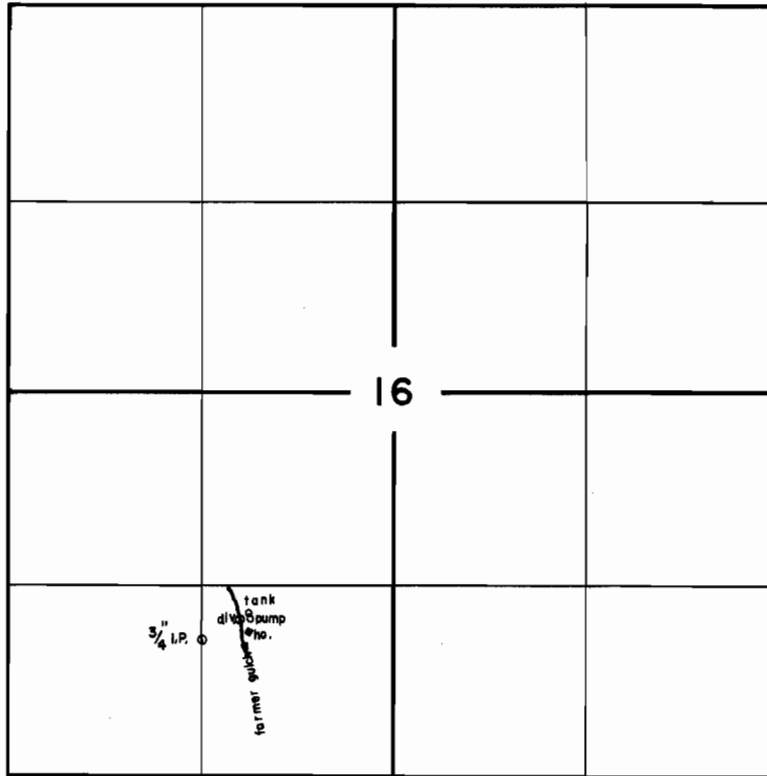

FINAL PROOF SURVEY
UNDER

Application No. 38127.... Permit No. 28414....
IN NAME OF

.....GEORGE C. GOOD & RENEE GOOD.....

Surveyed OCT. 20. 1964, by R.B. STEIMER