


T.17S. R.2W.W.M.

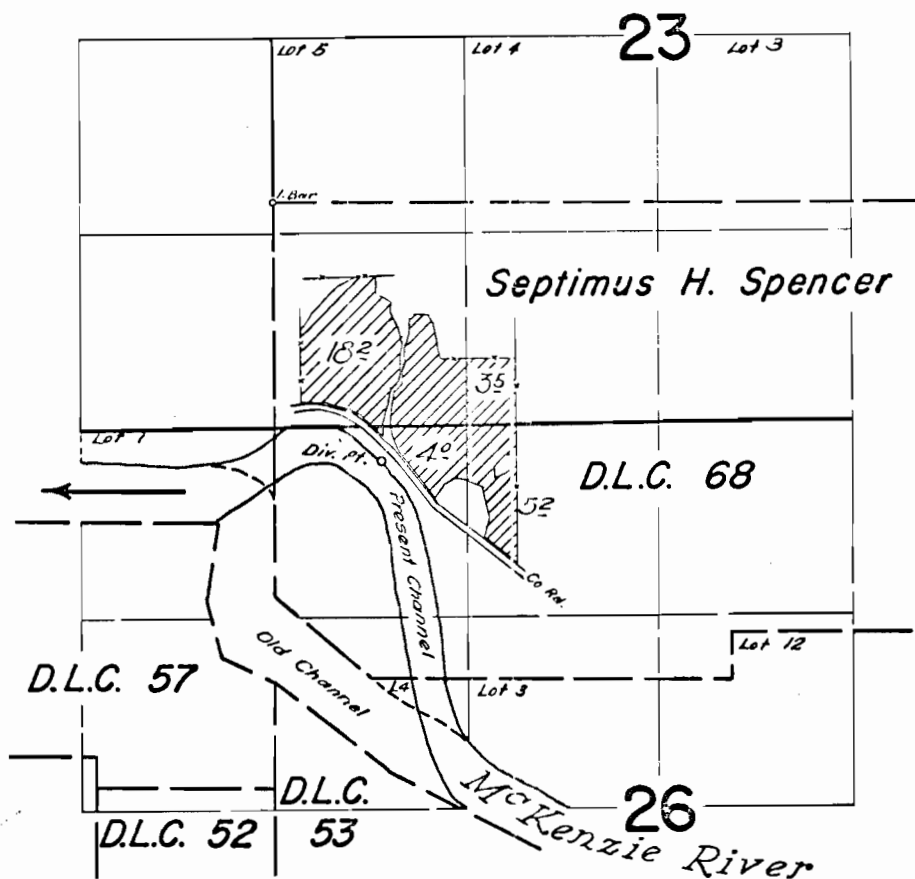

FINAL PROOF SURVEY
UNDER

Application No. 34756... Permit No. 27285...
IN NAME OF

FRITZ MILLER

Surveyed May 8, 1963, by *R. Jackson*