T. 11 S. R. 1 W. & 2 W. W.M.

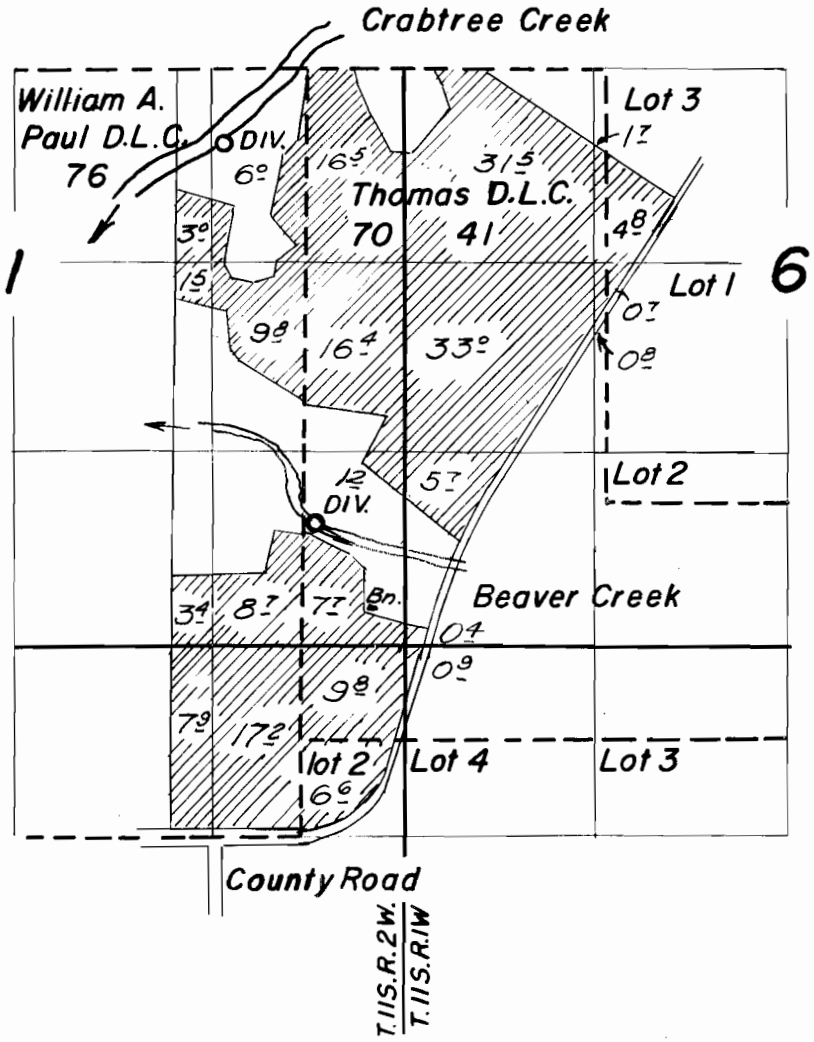

FINAL PROOF SURVEY
UNDER

Application No. 37289 Permit No. 27773
IN NAME OF

Lane W. Crossley

Surveyed Nov. 6 1963, by Floyd L. Siegmund

2-1963-B