


T.6S.R.1E.W.M.

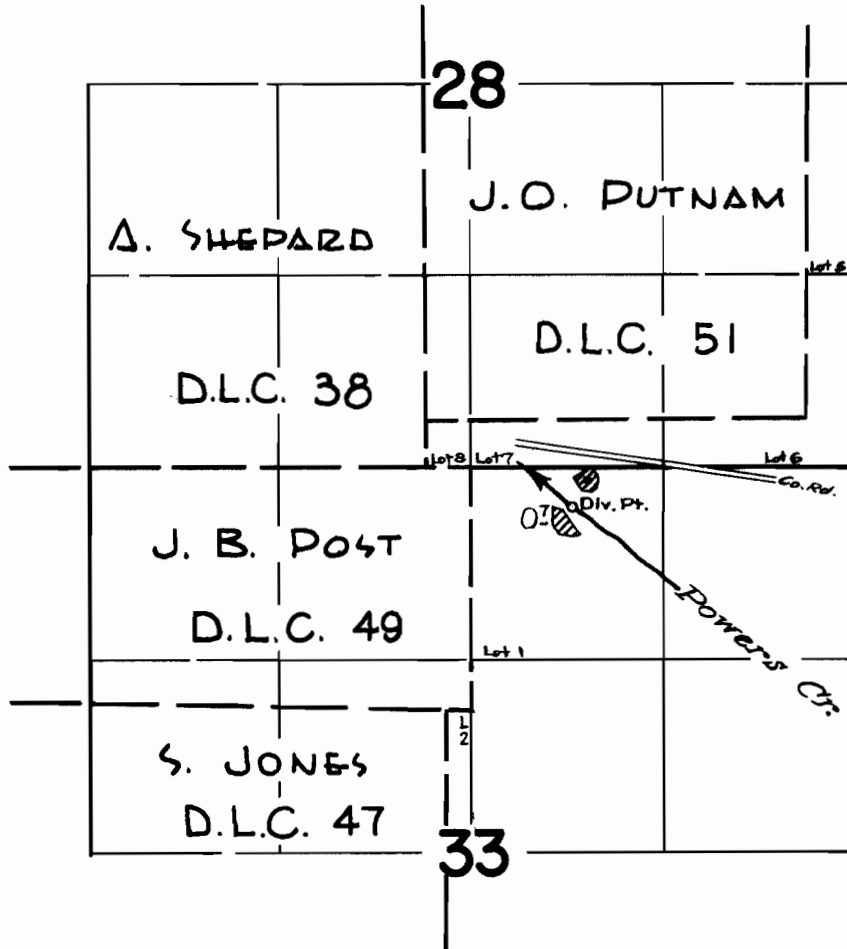

**FINAL PROOF SURVEY**  
UNDER

Application No. 31940 Permit No. 25183  
IN NAME OF

ROBERT W. SMITH

Surveyed July 2, 1963, by T. LAUER

19