


T. 4 S. R. 10 W. W. M.

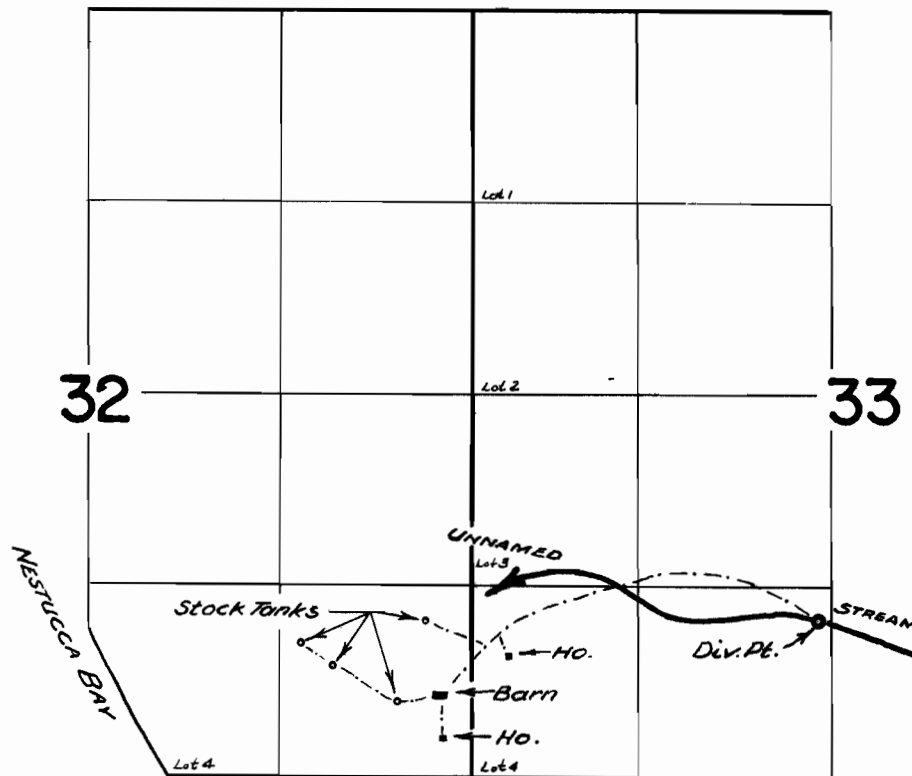

*Location of Div. Pt., Stream, & Pipe Line
Sketched from Applicants Map*

**FINAL PROOF SURVEY
UNDER**

Application No. 33616 Permit No. 26581
IN NAME OF

HAROLD L. THROOP

Surveyed JULY 25 1963, by C. BAKER