


T. 4 S. R. 9 W. W.M.

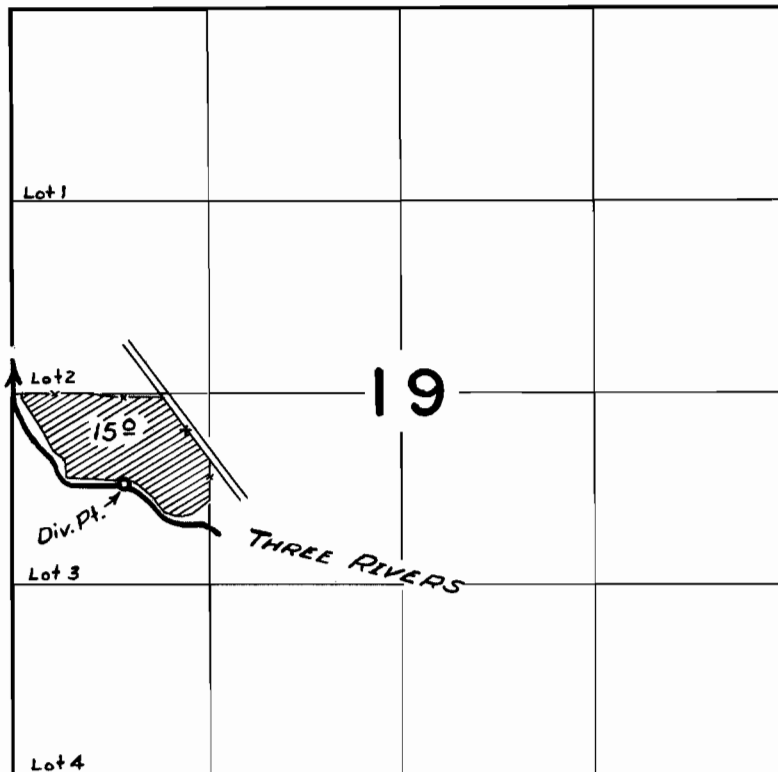

FINAL PROOF SURVEY UNDER

Application No. 33855 Permit No. 26689
IN NAME OF

CURTICE EDWARD YATES

Surveyed JULY 23 1963, by C. BAKER

1963-X

M.B.