


T. I S. R. 10 W. W. M.

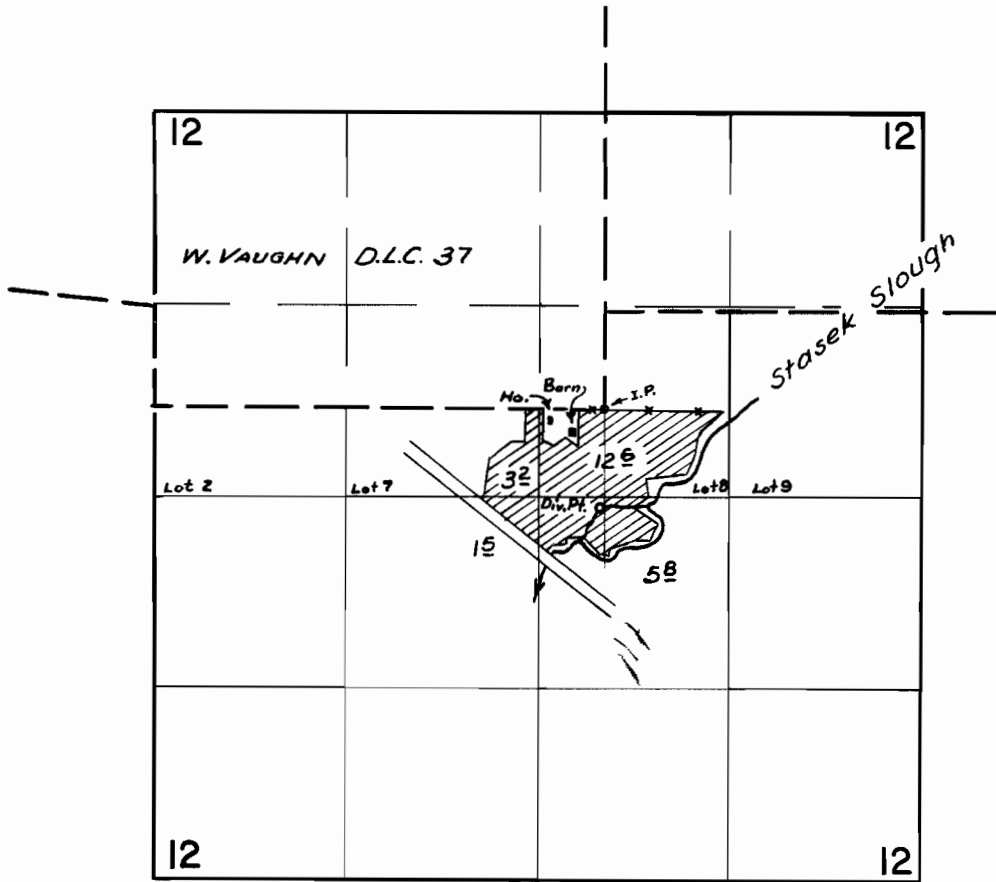

FINAL PROOF SURVEY UNDER

Application No. 33899 Permit No. 26710
IN NAME OF

SAMUEL VERMILYEA

Surveyed JULY 26 1963, by C. BAKER