


T. 5 S. R. 10 W. W. M.

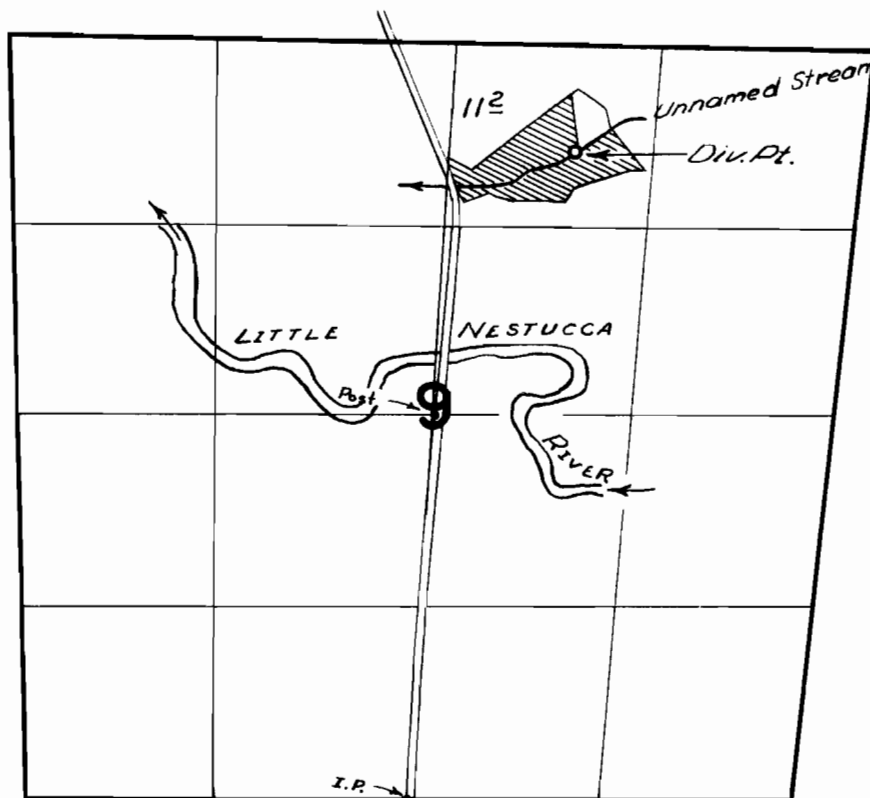

FINAL PROOF SURVEY
UNDER

Application No. 34147 Permit No. 26906
IN NAME OF

ROY C. DUNN

Surveyed JULY 30 1963, by C. BAKER

1963-X

M.B.