


T. 3 S. R. 9 W. W.M.

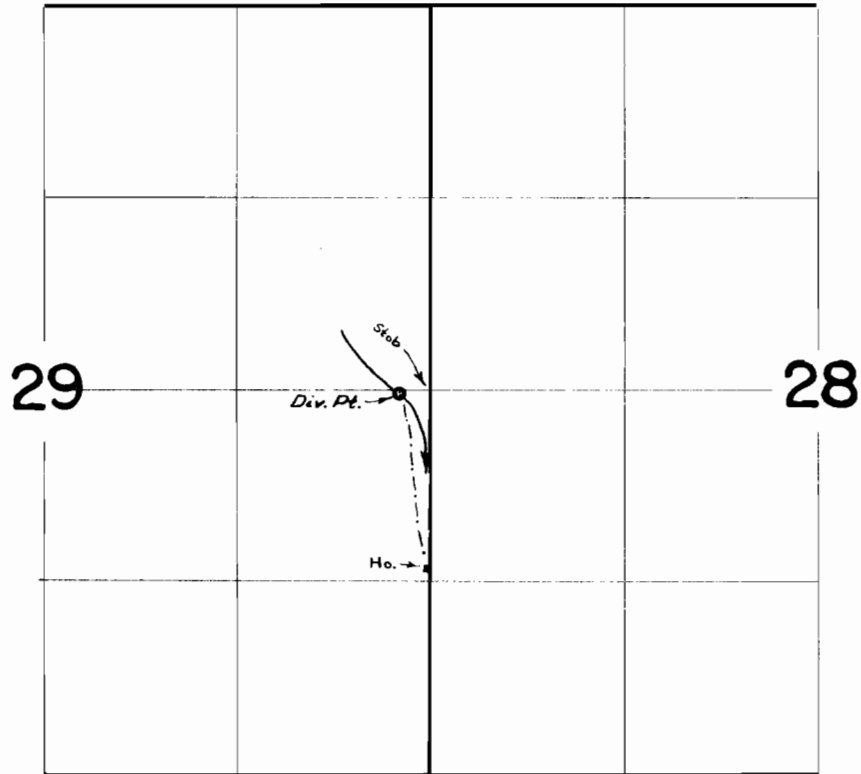

**FINAL PROOF SURVEY**  
UNDER

Application No. 37017 . Permit No. 27561  
IN NAME OF

*MAX G. CARVER*

Surveyed *JULY 23* 1963, by *C. BAKER*