


T. 5 S. R. 11 W. W. M.

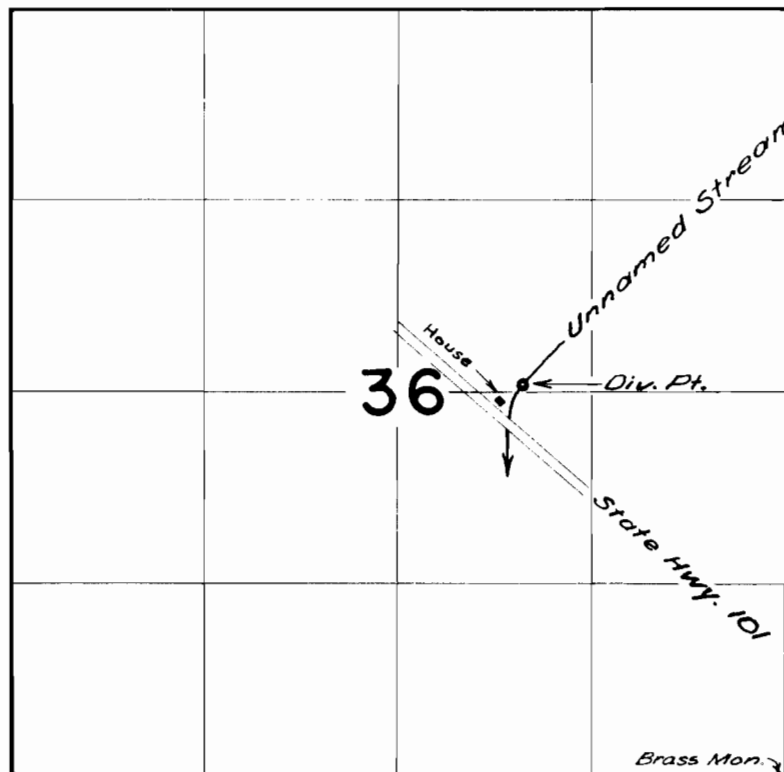

FINAL PROOF SURVEY
UNDER

Application No. 37026 Permit No. 27596
IN NAME OF

... *WILBUR & MARIAN CONLEE* ...

Surveyed *JULY 24 1963*, by *C. BAKER*