


# T.2S.R.9W.W.M.

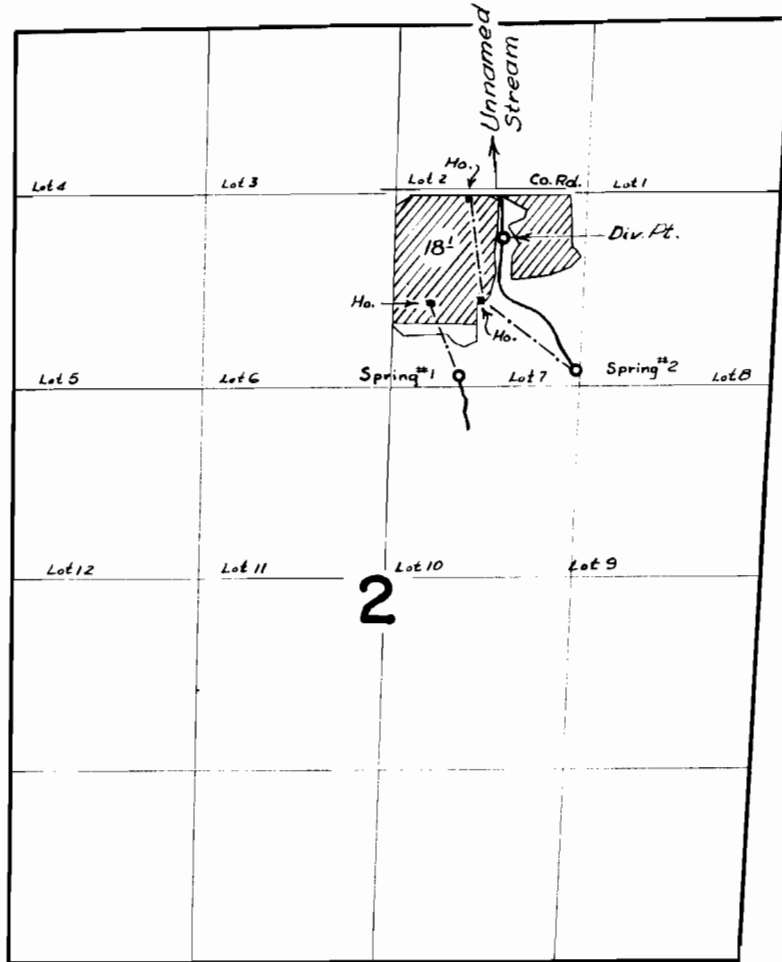

## FINAL PROOF SURVEY UNDER

Application No. 37161 Permit No. 27851  
IN NAME OF

*RUDOLPH FENK*

Surveyed July 22 1963, by C. BAKER