


T. 5 S. R. 10 W. W.M.

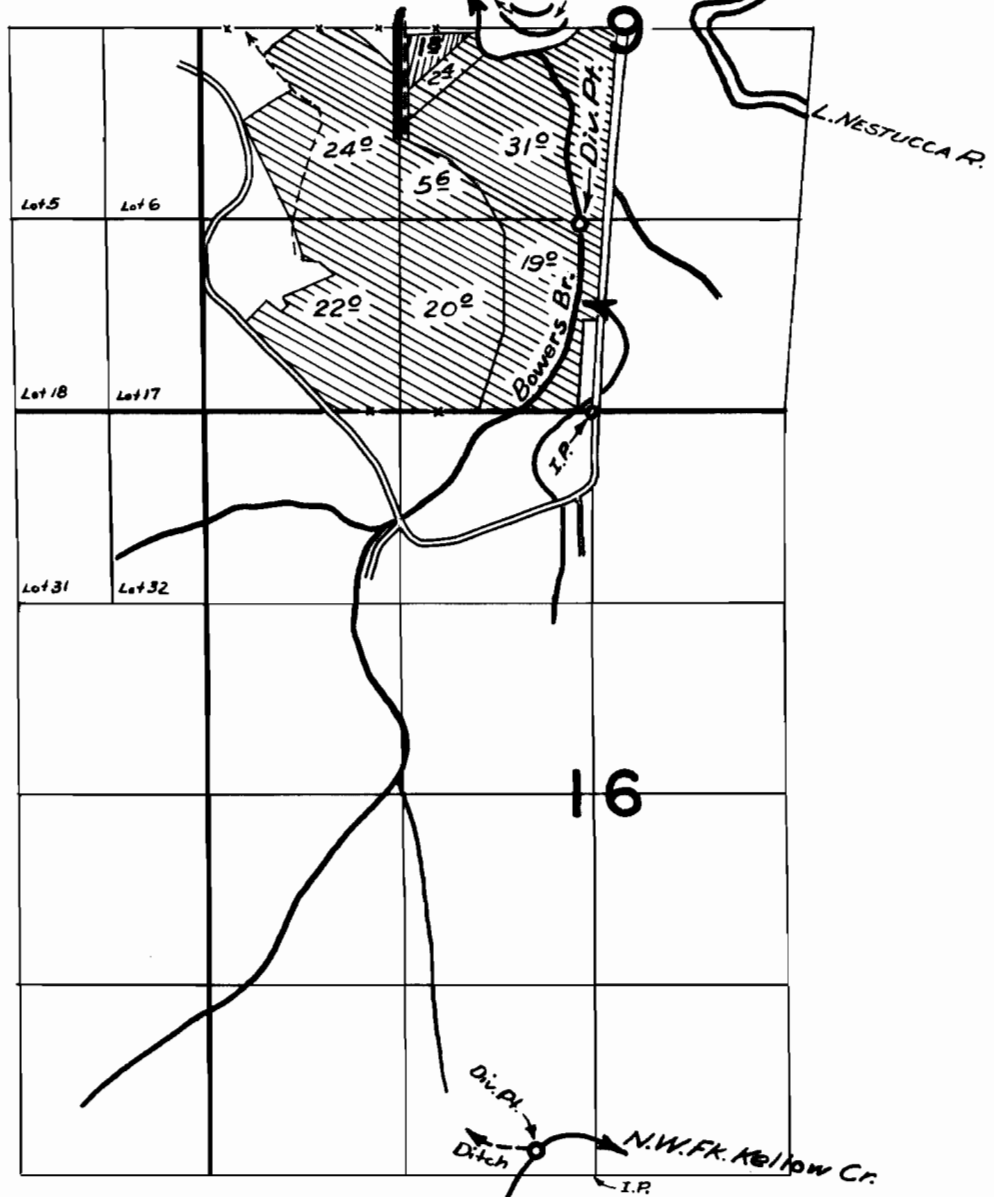

FINAL PROOF SURVEY
UNDER

Application No. 38105 Permit No. 28404
IN NAME OF

JOHN L. CRAVEN JR.

Surveyed JULY 30 1963, by C. BAKER

1963-X
1957-M
1961-D M.B.