


G 1615
32018

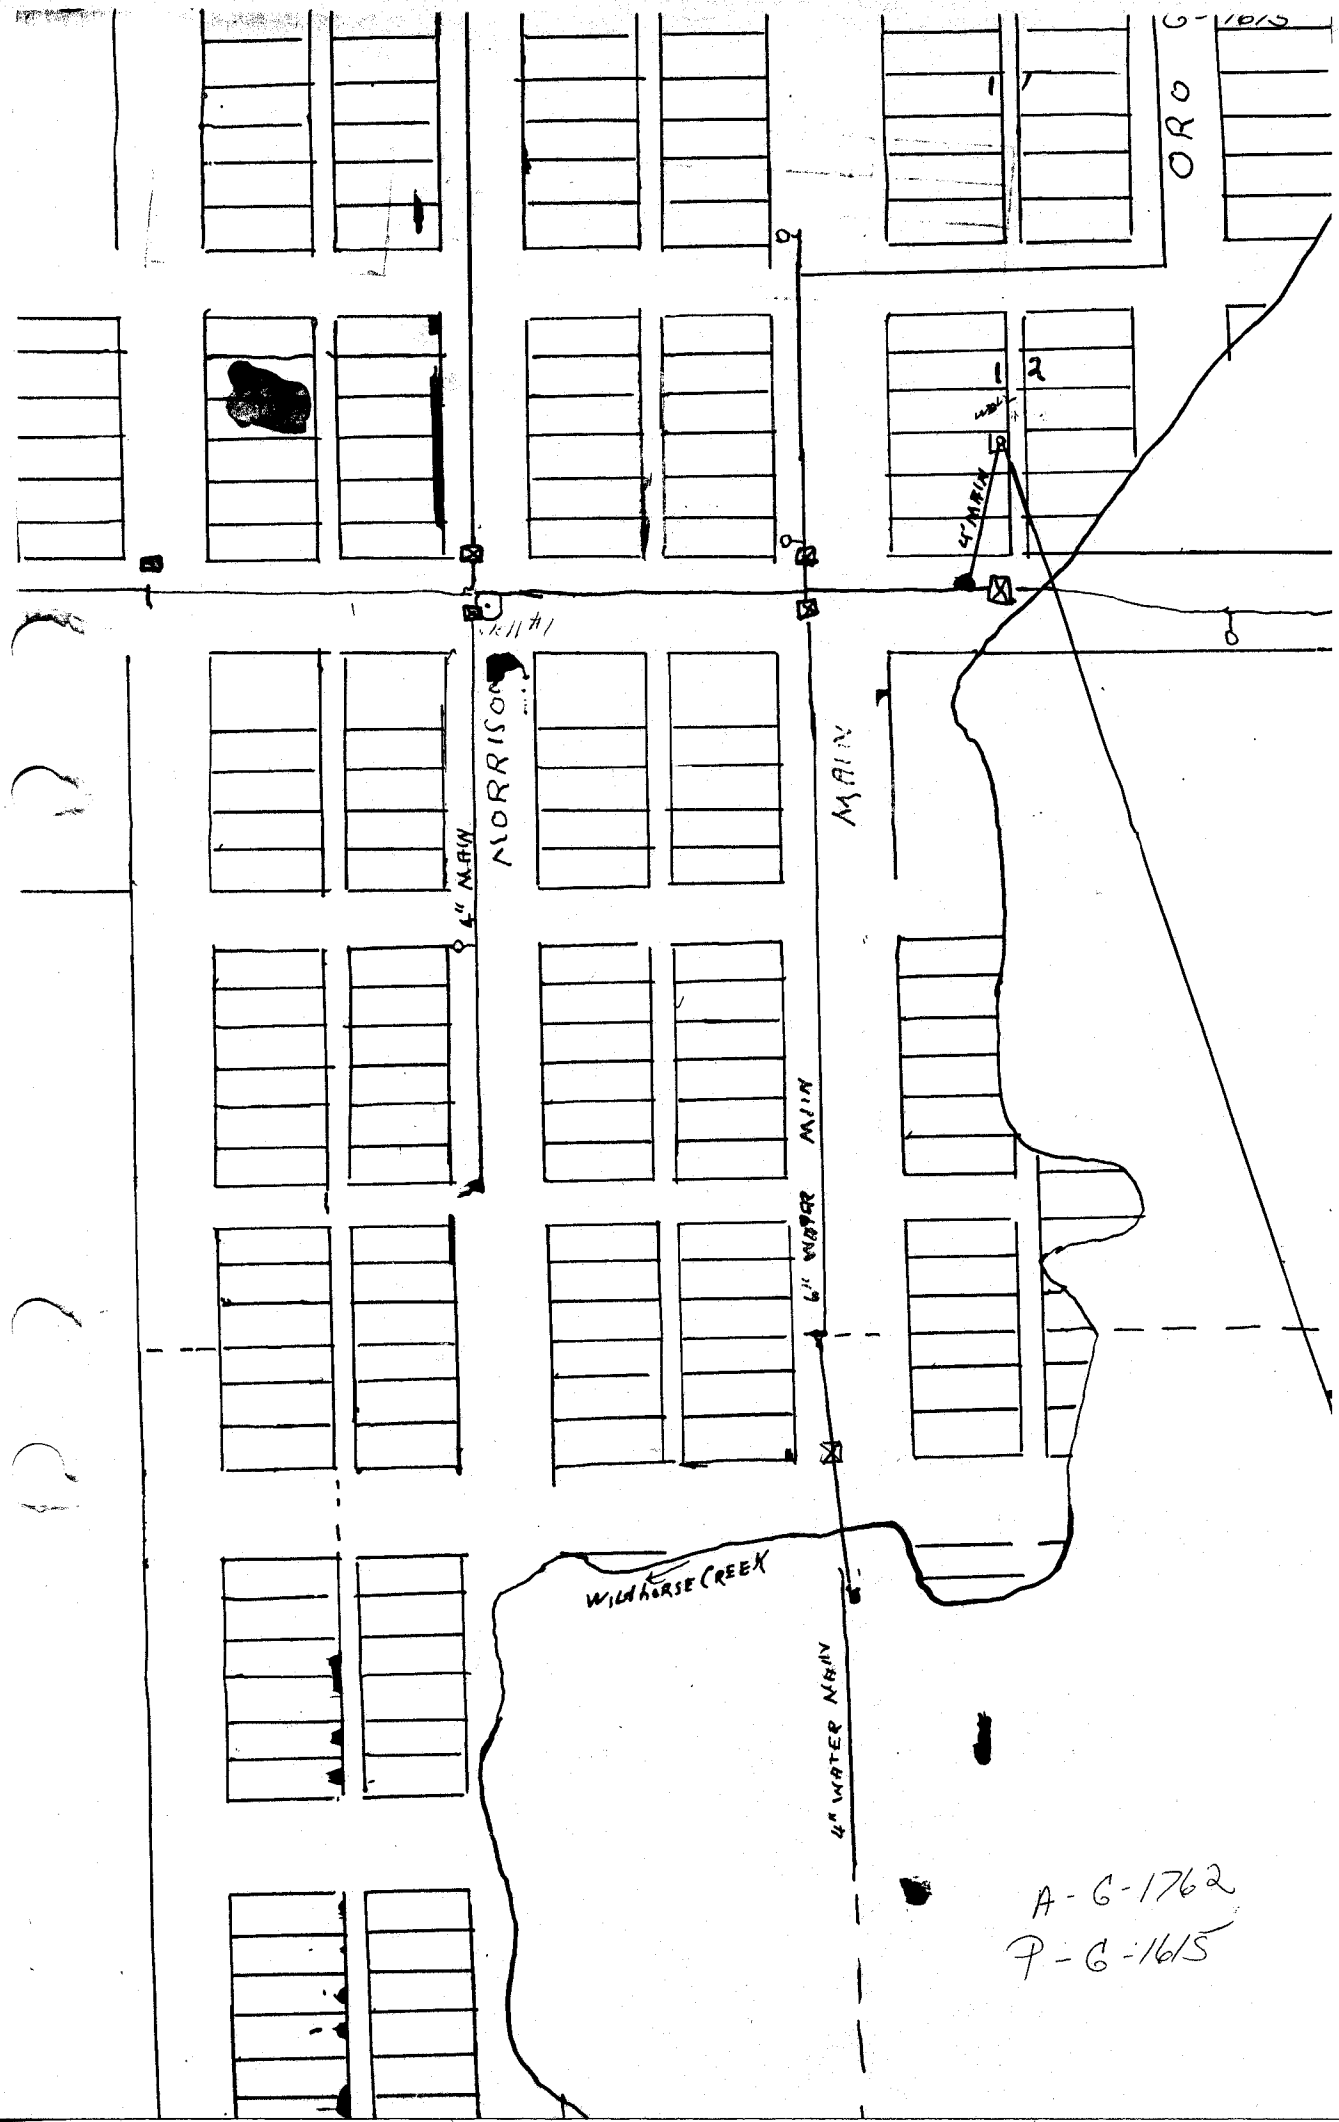

A-G-1762
P-G-1615