


T.2&1 N. R. 3 W.W.M.

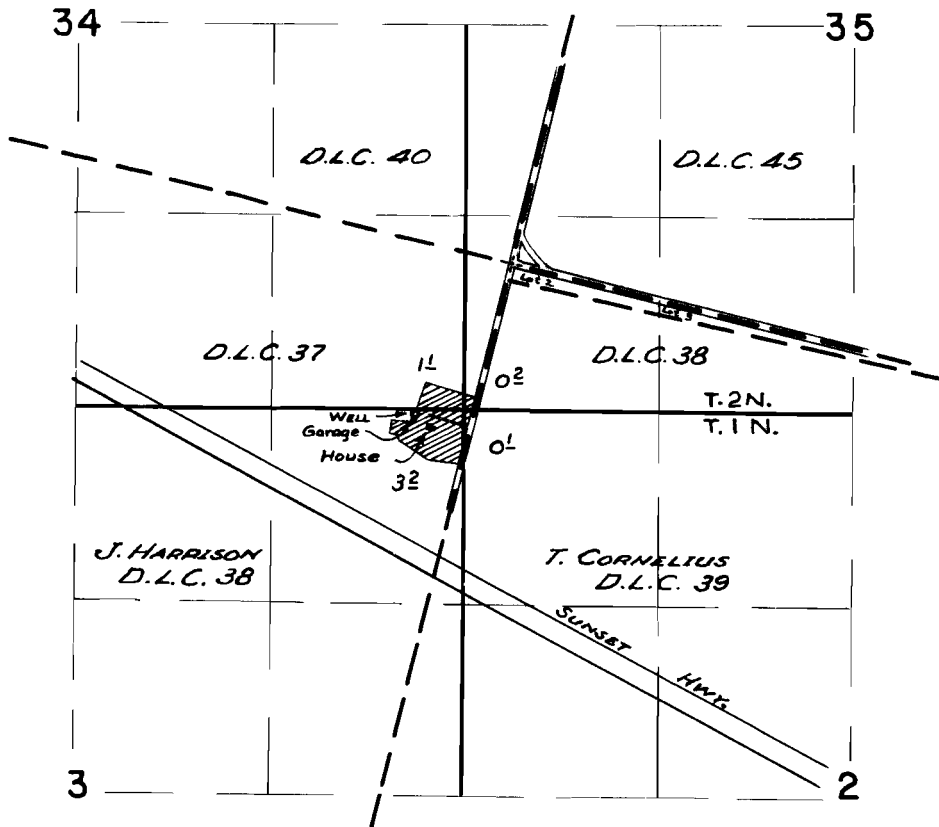

FINAL PROOF SURVEY UNDER

Application No. G-1681 Permit No. G-1543
IN NAME OF

WARREN C. BAUGH

Surveyed MAR. 19 1963, by m. Bish