


# T. 2 S. R. 1 W. W. M.

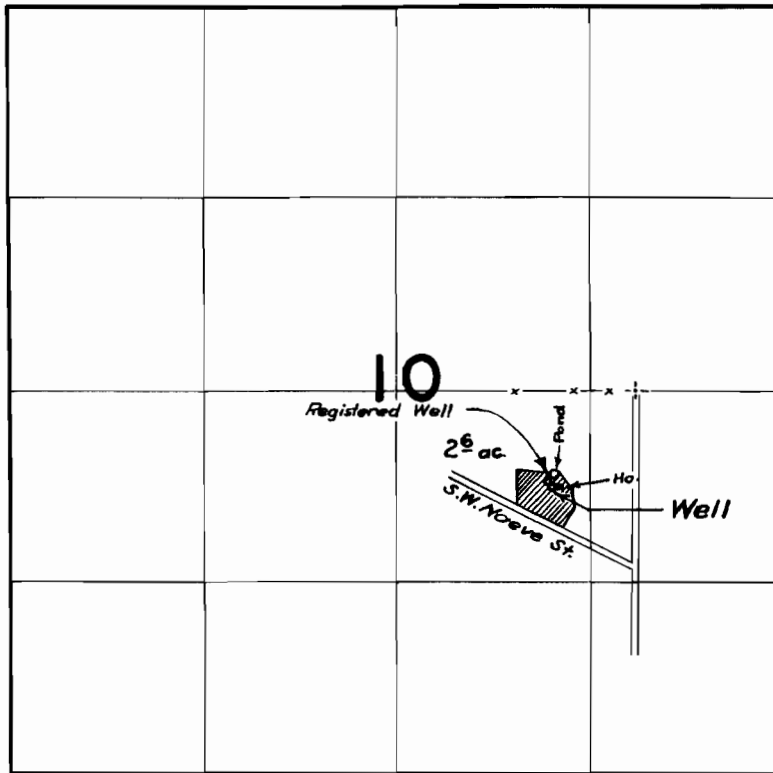

## FINAL PROOF SURVEY UNDER

Application No. G-2309 Permit No. G-2170  
IN NAME OF

WILLIAM B. SANDERS & CLAIRE M. SANDERS

Surveyed April 1 1963, by m. Bush