


T. 1 N. R. 2 W. W. M.

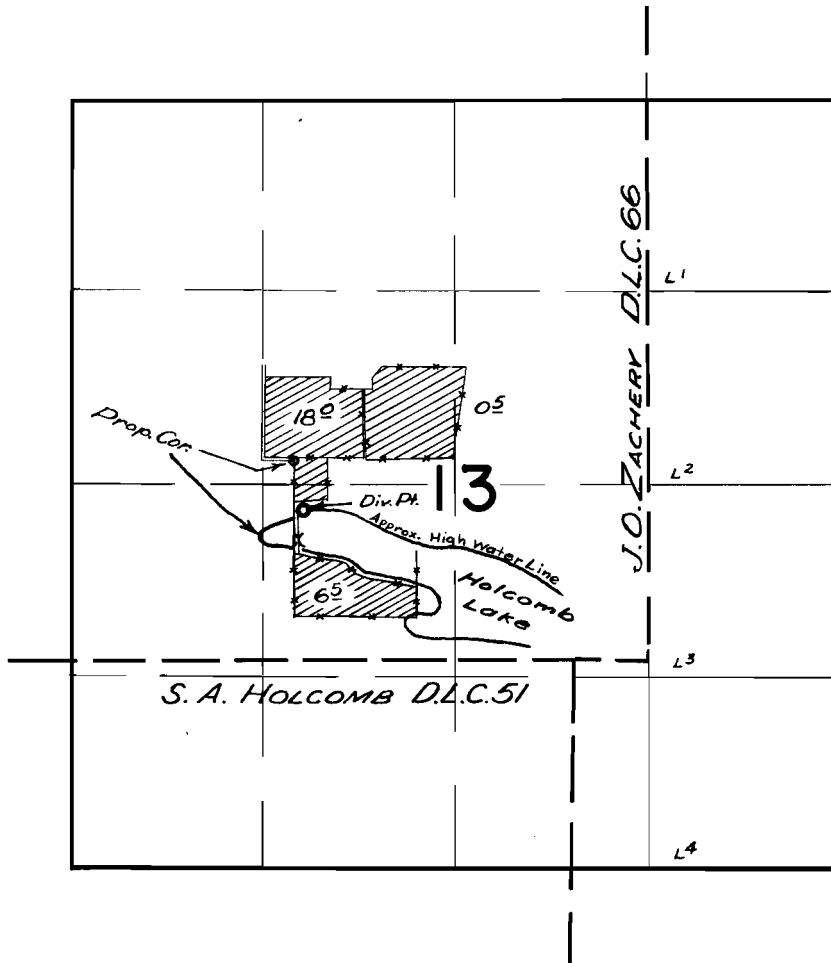

FINAL PROOF SURVEY
UNDER

Application No. 31708 Permit No. 25822
IN NAME OF

JAGGI BROTHERS

Surveyed July 31 1963, by M. Bish