


T. 2 S. R. 2 W. W. M.

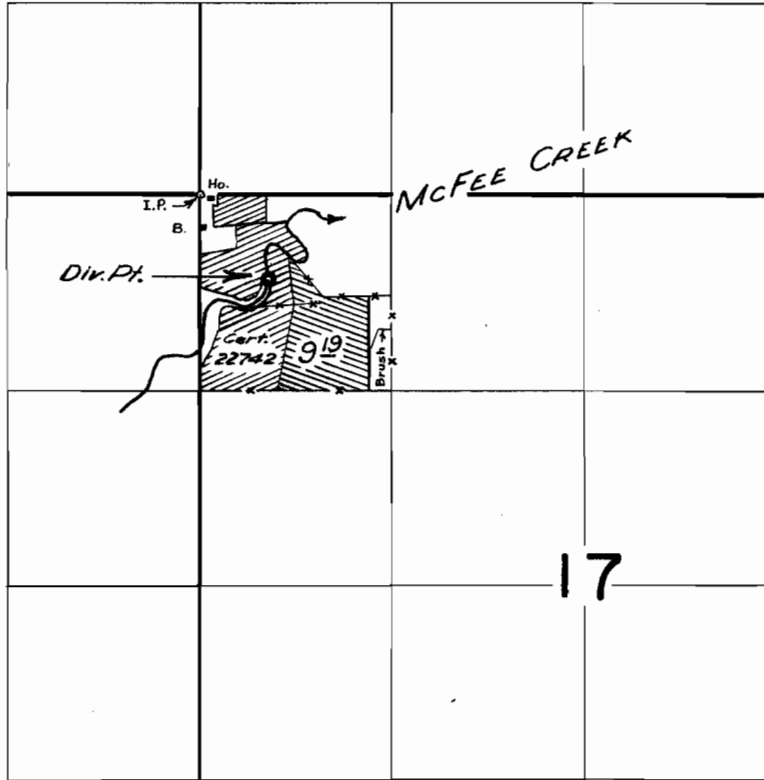

FINAL PROOF SURVEY
UNDER

Application No. 33063 Permit No. 26149 

IN NAME OF

DALE P. & PATRICIA A. GOSSELIN

Surveyed April 23 1963, by M. Bish