


# T. I S. R. I W. W. M.

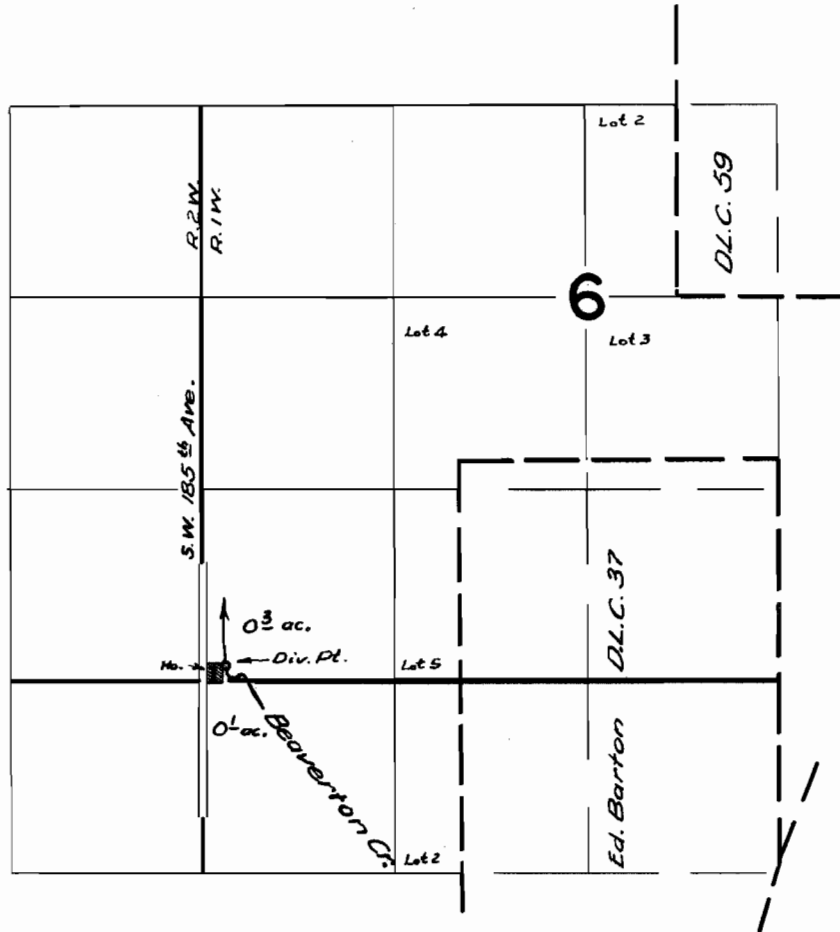

## FINAL PROOF SURVEY UNDER

Application No. 33333 Permit No. 26363  
IN NAME OF

ALBERT R. SMITH

Surveyed MAR. 27 1963, by M. Bish