


T. 1 & 2 N. R. 3 W. W.M.

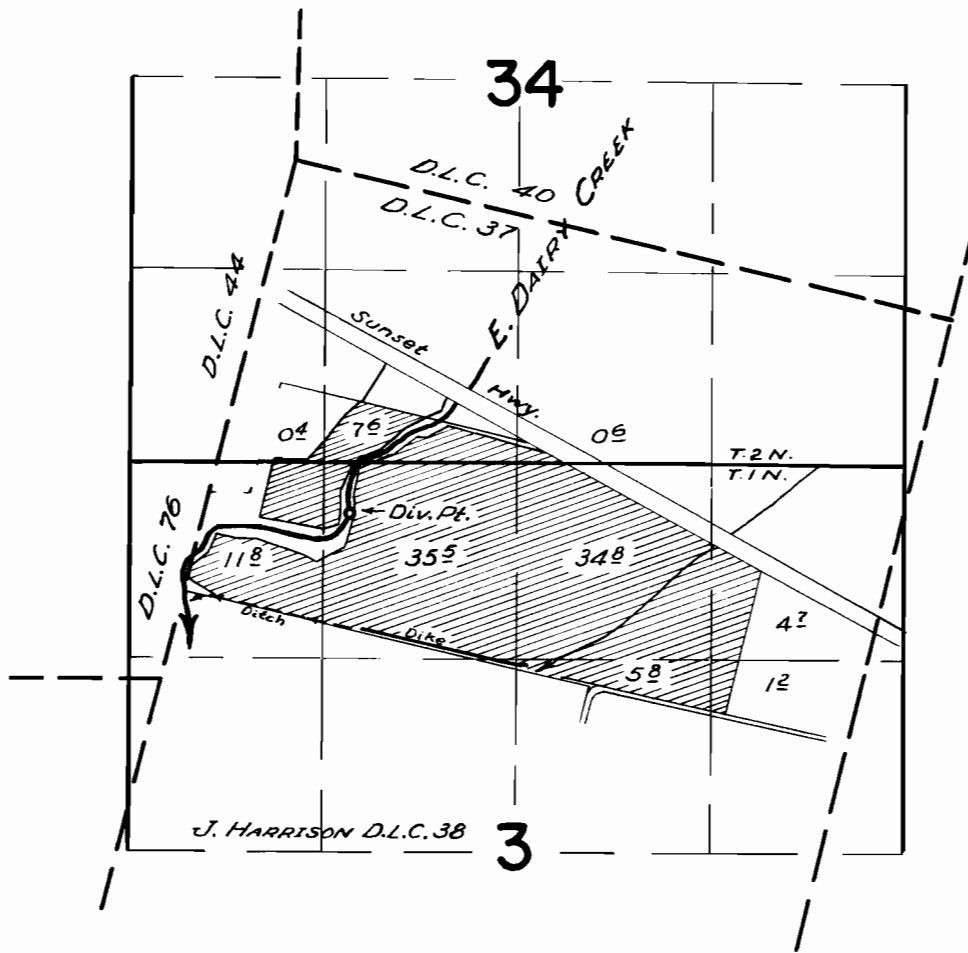

FINAL PROOF SURVEY UNDER

Application No. 34669 Permit No. 27229
IN NAME OF

REMI & ROSE COUSSENS

Surveyed MAR. 19 1963, by m. Bish