


T. I S. R. 2 W. W. M.

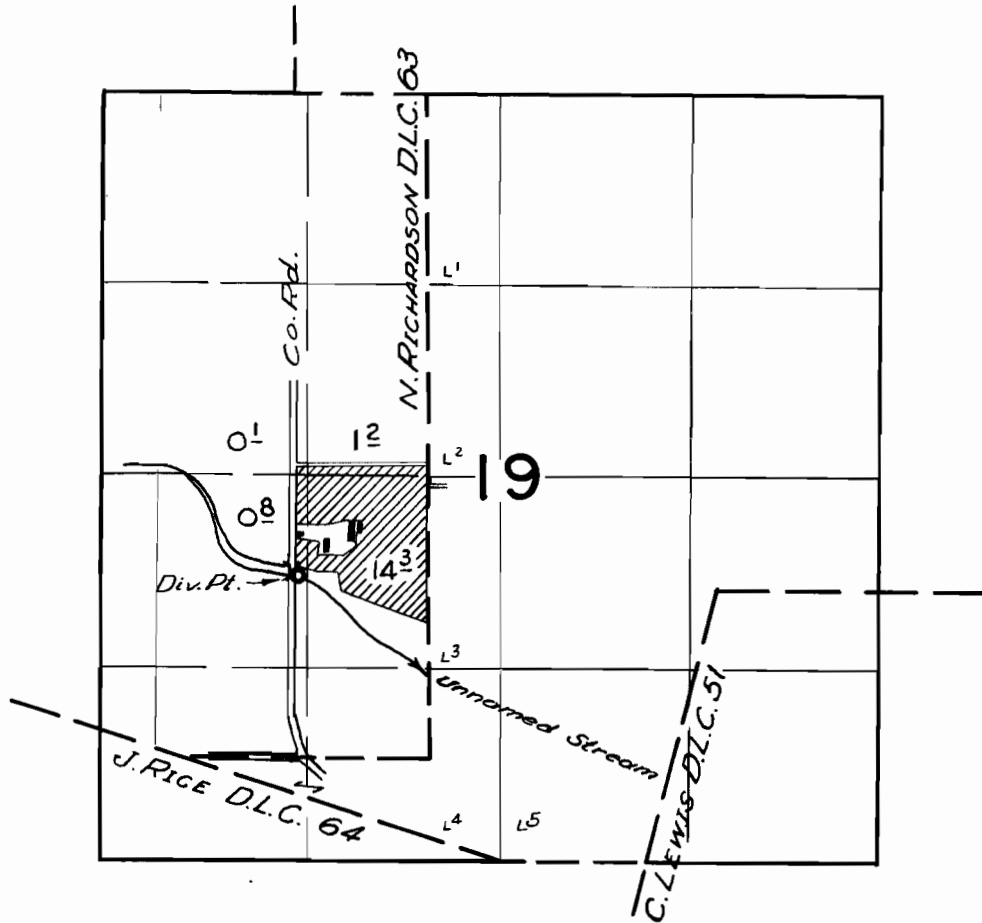

FINAL PROOF SURVEY UNDER

Application No. 37365 Permit No. 27814
IN NAME OF

VINCENT D. DOBBIN

Surveyed Aug. 23 1963, by *m. Bish*