


T.2 N. R.4 W.W.M.

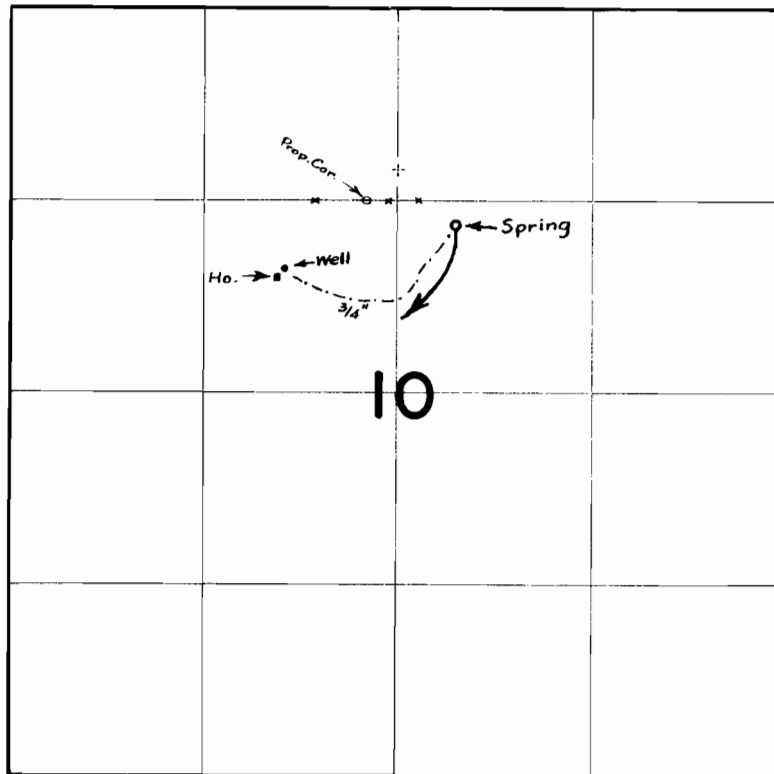

Note: Location of pipe line is approx.

FINAL PROOF SURVEY
UNDER

Application No. 38212 Permit No. 28472
IN NAME OF

JOE F. KERR

Surveyed MAR. 26 1963, by M. Bish