


T.4 S.R.3 W.W.M.

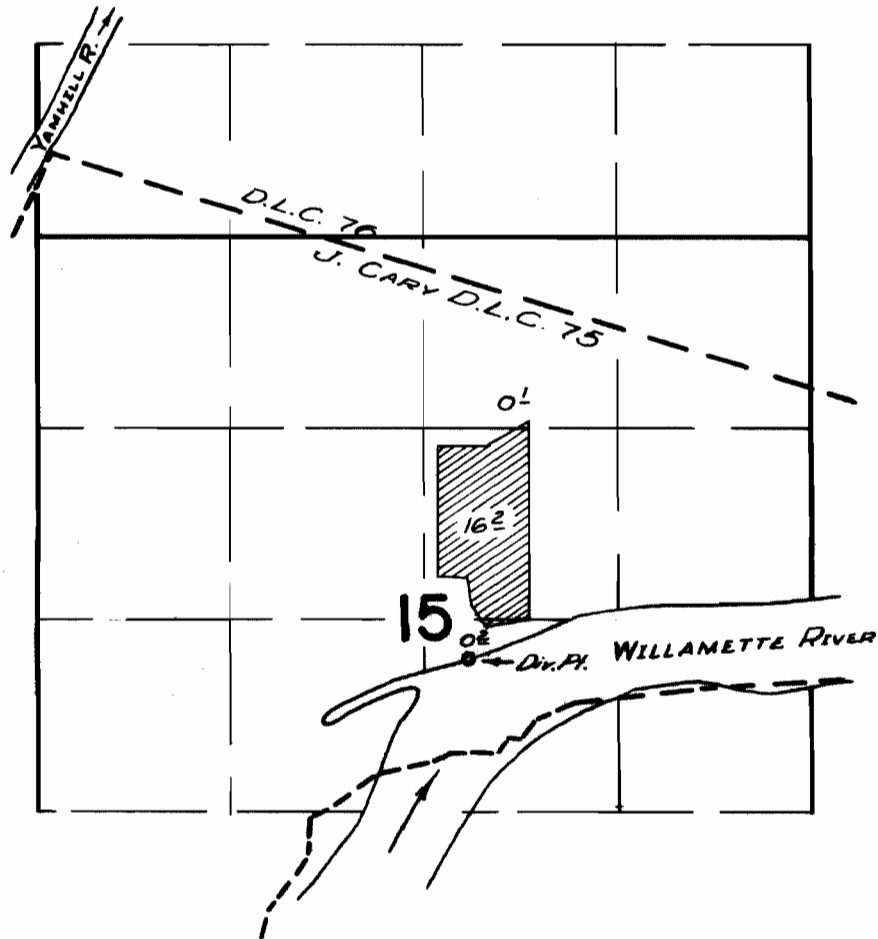

FINAL PROOF SURVEY UNDER

Application No. 29628 Permit No. 23340
IN NAME OF

LLOYD E. EWING

Surveyed April 11 1963, by m. Biel