


T. 5 S. R. 6 W. W.M.

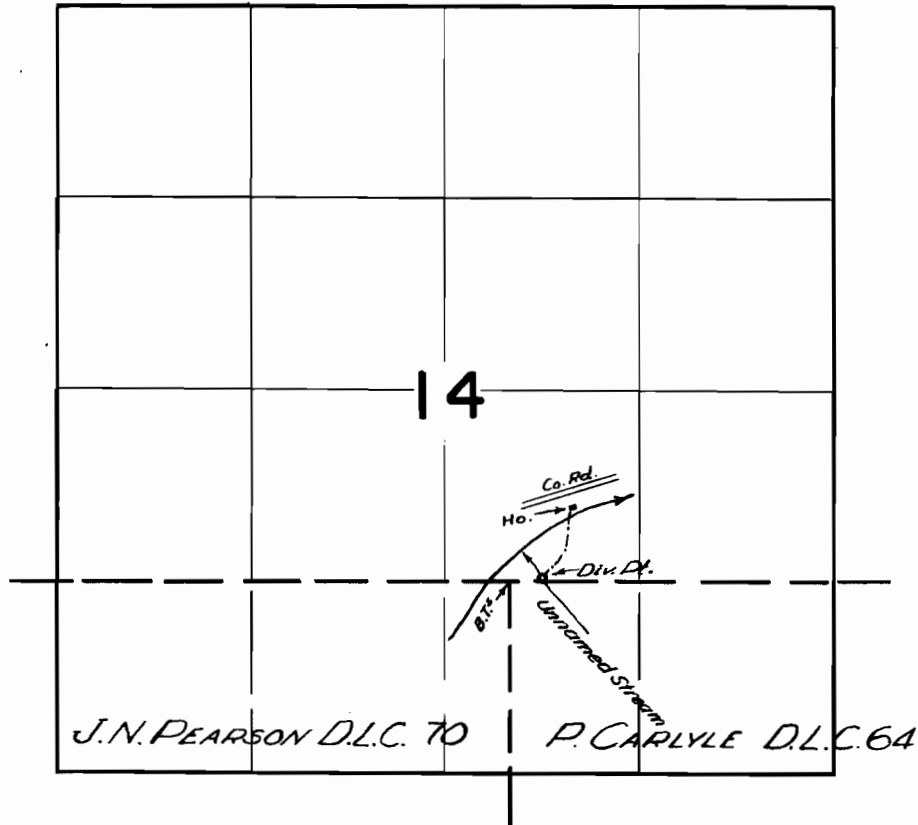

**FINAL PROOF SURVEY**  
UNDER

Application No. 31216 Permit No. 24681  
IN NAME OF

LLOYD L. LILLARD

Surveyed MAY 16 1963, by M. Bish