


T. 4 S. R. 3 W. W. M.

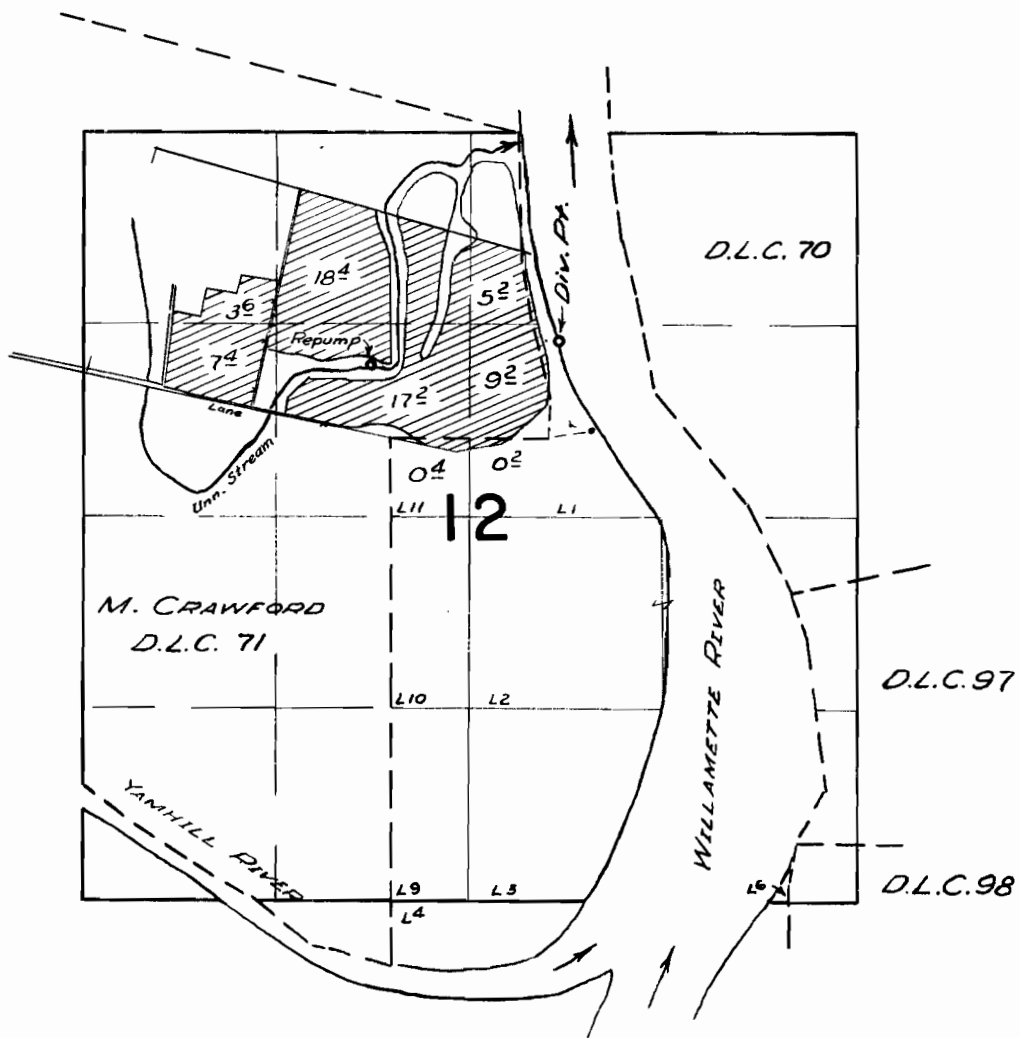

FINAL PROOF SURVEY UNDER

Application No. 31639 Permit No. 24938
IN NAME OF

JOHN "JACK" SHELBURNE, JR.

Surveyed APRIL 11, 1963, by m. Bish