


T. 3 S. R. 2. W. W.M.

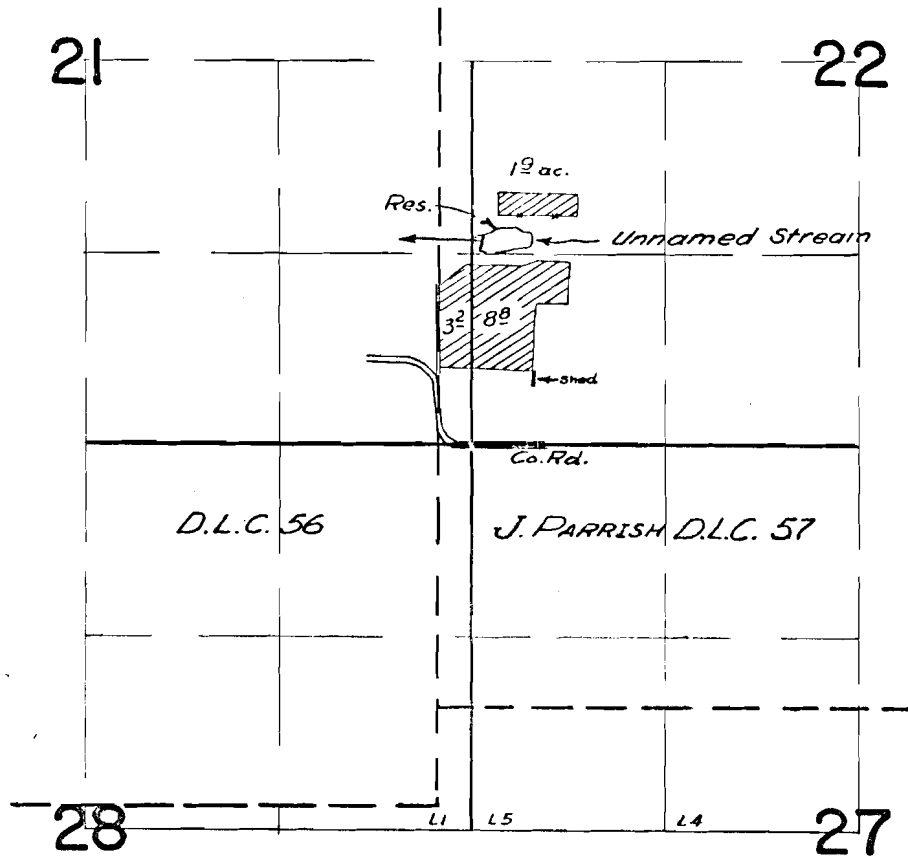

FINAL PROOF SURVEY
UNDER

Application No. *31627* *25466*
R-31626 Permit No. *R-2125*
IN NAME OF

.....*ARTHUR O. PARRISH*.....

Surveyed *April 9, 1963*, by *m. Beal*