


T. 3 S. R. 2. W. W.M.

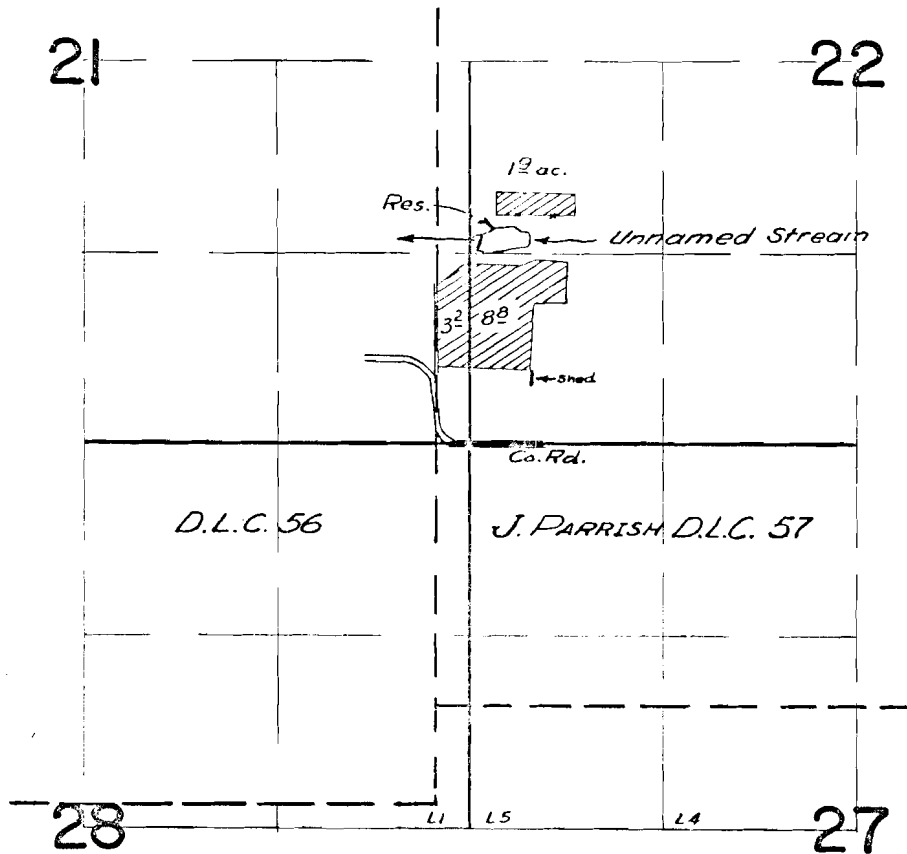

FINAL PROOF SURVEY  
UNDER

Application No. *31627* *25466*  
*R-31626* Permit No. *R-2125*  
IN NAME OF

*ARTHUR O. PARRISH*

Surveyed *April 9, 1963*, by *T. Beah*